

KOLB LAND CONSULTING, INC.
 LAND SURVEYING • SUBDIVIDING • LAND PLANNING


LAKE GENEVA, WISCONSIN 53147

WHITEWATER, WISCONSIN 53190

PLAT OF SURVEY OF

A PARCEL OF LAND LOCATED IN THE
 SOUTHEAST 1/4 OF THE SOUTHEAST
 1/4 OF SECTION 26, TOWN 2 NORTH,
 RANGE 17 EAST, CITY OF LAKE
 GENEVA, WALWORTH COUNTY, WISCONSIN.

ORDERED BY: ANDREW A. GOLKO
 1909 W. BELMONT AVE.
 CHICAGO, IL 60657

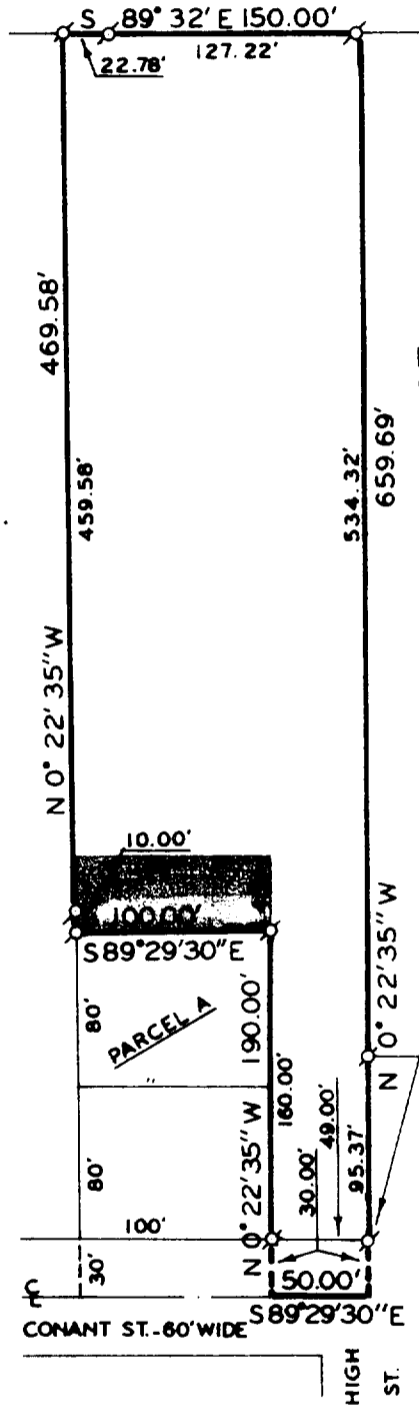

NOTE:
 SHADED PARCEL
 IS A PROPOSED
 ADDITION TO
 PARCEL A.

NOTE:
 IRON PIPE FOUND
 1.00' WEST OF
 CORNER ON LINE
 AS SHOWN ON
 SURVEY PLAT
 DATED JULY
 18, 1973.



SCALE: 1"=100'

LEGEND

⊕ - IRON PIPE FOUND

I, HAROLD H. KOLB, DO HEREBY CERTIFY THAT I HAVE
 SURVEYED THE PROPERTY HEREON DESCRIBED ACCORDING
 TO THE OFFICIAL RECORDS AND THAT THE PLAT HEREON
 IS A CORRECT REPRESENTATION OF THE LOT LINES.

Harold H. Kolb

HAROLD H. KOLB
 WISCONSIN REGISTERED LAND SURVEYOR, S-187

DATE Jan. 29, 1979