
HAROLD H. KOLB

REGISTERED PROFESSIONAL LAND SURVEYOR LAKE GENEVA, WISCONSIN



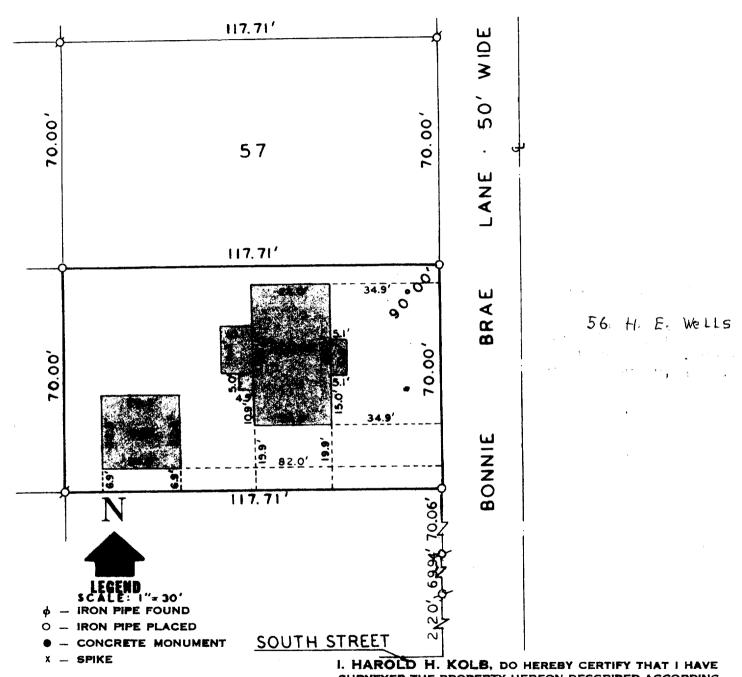

I. HAROLD H. KOLB, DO HEREBY CERTIFY THAT I HAVE SURVEYED THE PROPERTY HEREON DESCRIBED ACCORDING TO THE OFFICIAL RECORDS, AND THAT THE PLAT HEREON IS A CORRECT REPRESENTATION OF THE LOT LINES.

Herself H. Noll

HAROLD H. KOLB
WISCONSIN REGISTERED LAND SURVEYOR, S-187
DATE

REVISED: MARCH 10, 1976 7-550

RUNING 40-108 1M-6-71 R 1/ 1