
DESCRIPTION: Lot9, Block 15; Geneva Lake Crawford Manufacturer's Company Addittion, to the City of Lake Geneva, Walworth County, Wisconsin. CERTIFICATE: I, here by certify that I have on this the 15th day of April, 1949, surveyed the above described property, according to the official record on file in the office of the Recorder of Deeds in and for Walworth County, Wisconsin, and find that the measurements and bearings of the boundary lines of said property as taken at the site on this day, substantially agree with those in said official record and

that no encroachments exist. SIGNED AND SEALED THIS 16TH DAY OF APRIL 1949.

Joseph W. Bigi. Profession Engineer.

Elkhorn Wisconsin.

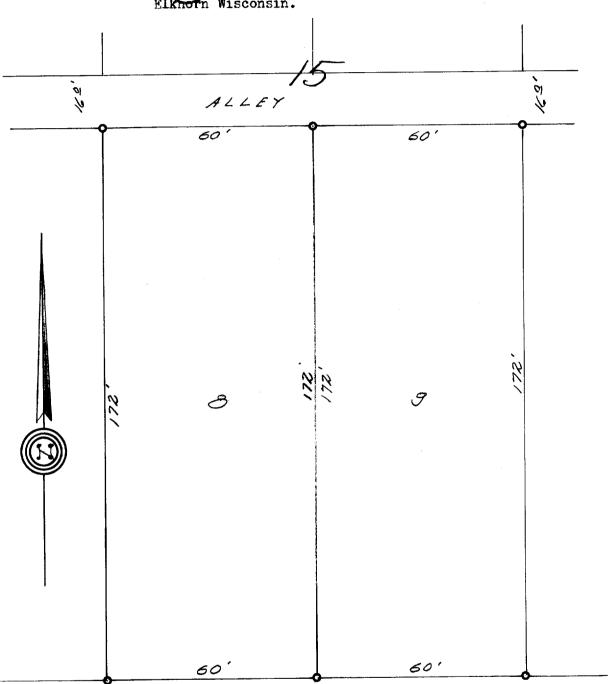

HASKINS

5T.