


ROGERS
CT



66'
ST.

CENTER

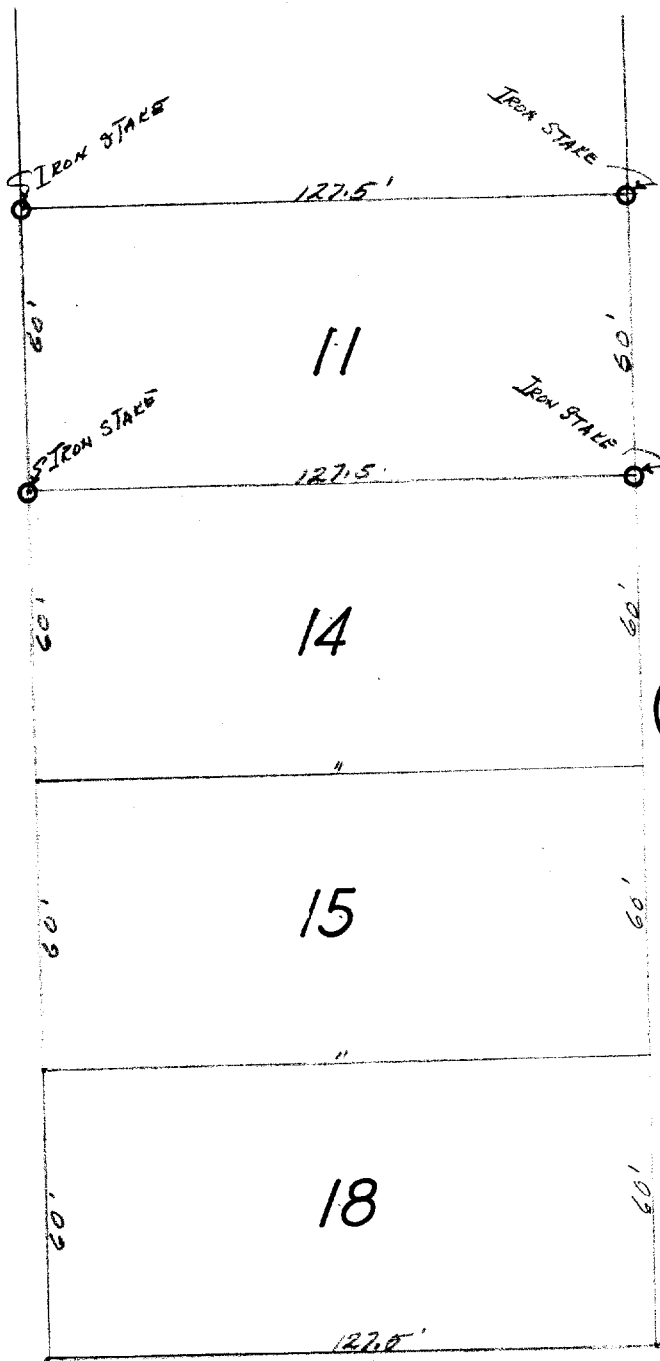

66' SPRING ST.

DESCRIPTION: Lot 11, Block 7 Geneva Lake Crawford Manufacturers Addition to the City of Lake Geneva, Walworth County, Wisconsin.
CERTIFICATE: I, hereby certify that I have on this the 12th day of July, 1949, surveyed the above described property according to the official record on file in the office of the Recorder of Deeds in and for Walworth County, Wisconsin, and find that the measurements and bearings of the boundary lines of said property as taken at the site, on this day, substantially agree with those in said official record and that no encroachments exist.
SIGNED AND SEALED ON THIS THE 19TH DAY OF JULY 1949.

Joseph M. Biagi
Joseph M. Biagi. Professional Engineer.
Elkhorn Wisconsin.