


HAROLD H. KOLB

REGISTERED PROFESSIONAL LAND SURVEYOR
LAKE GENEVA, WISCONSIN



SCALE 1" = 30'

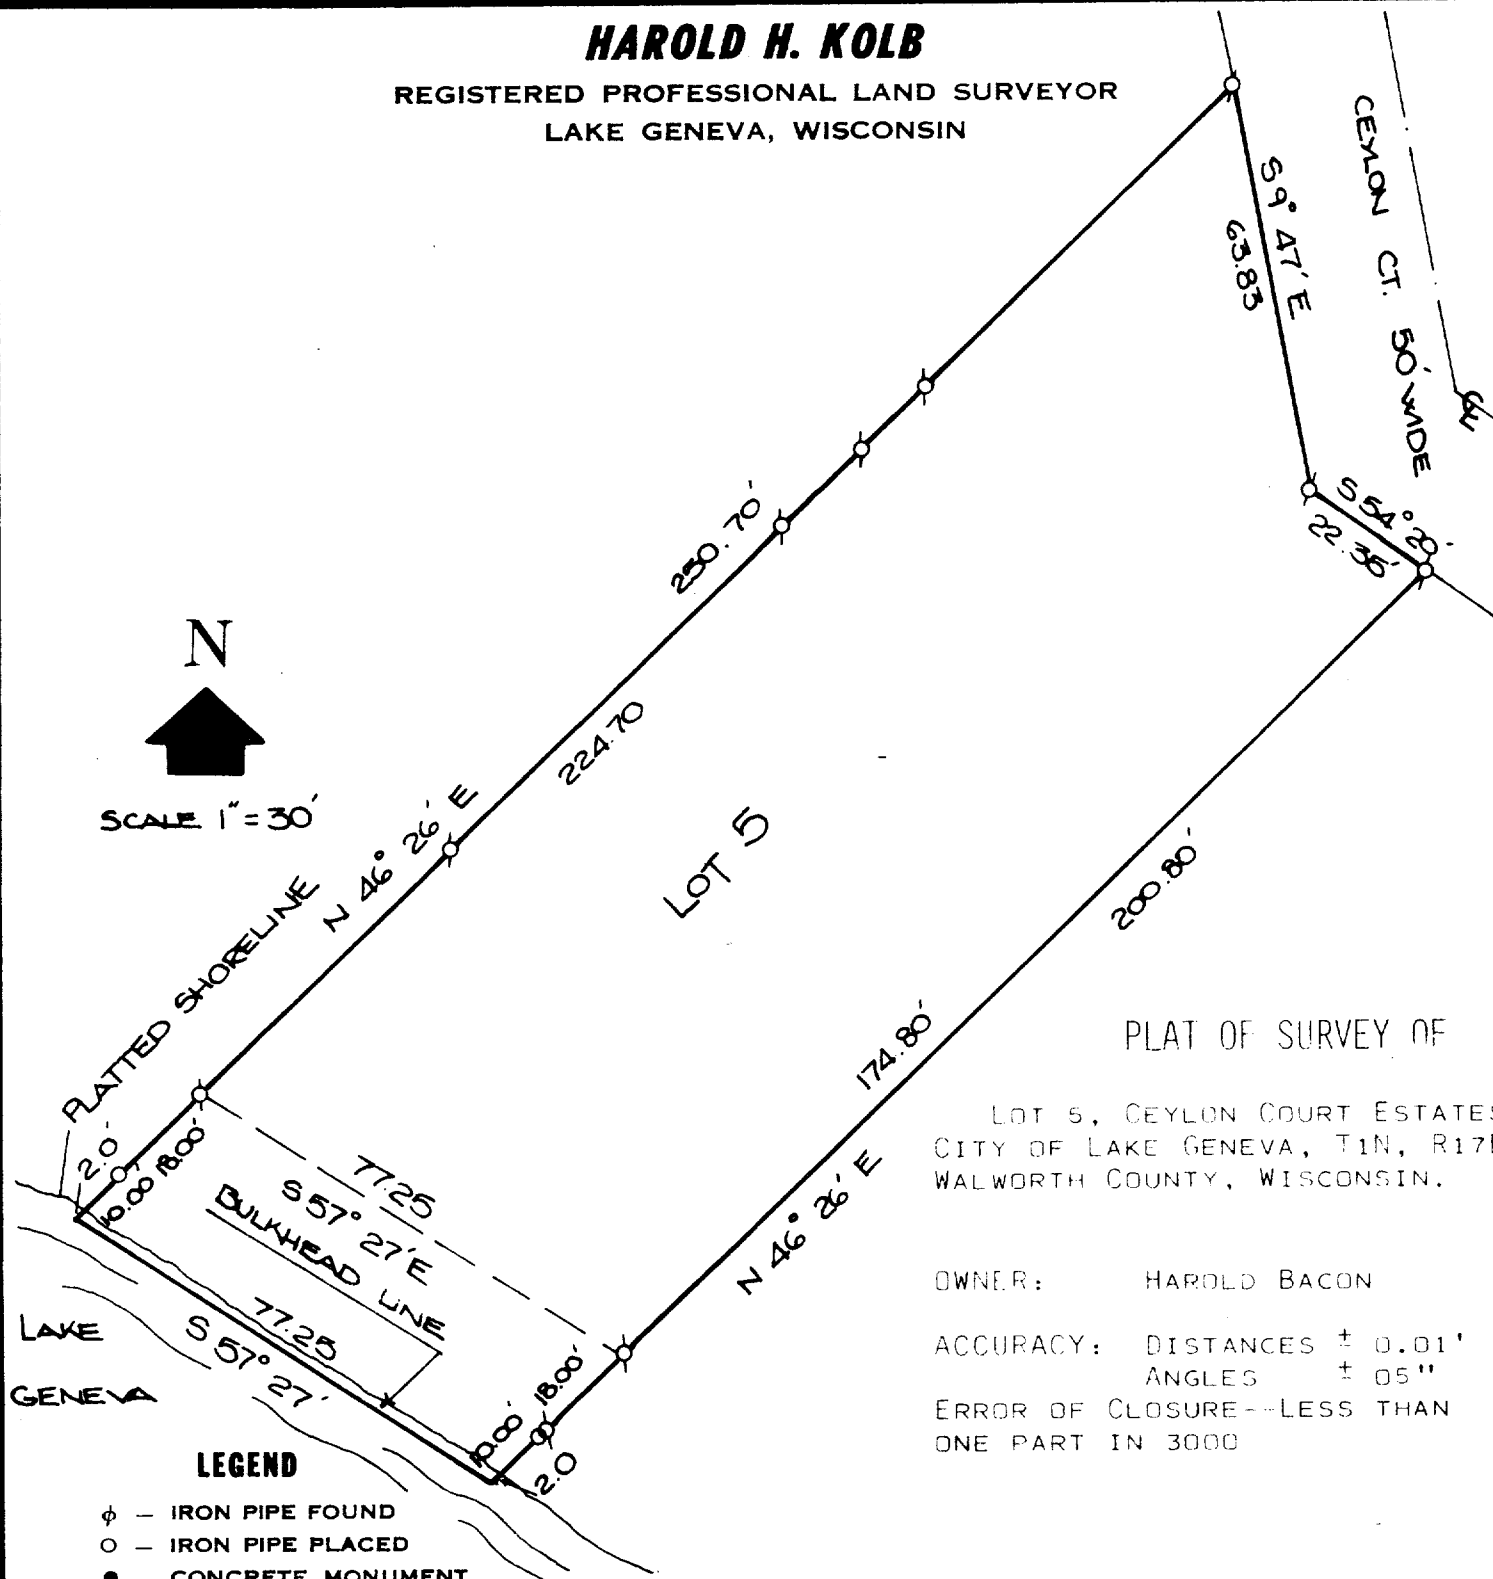

PLAT OF SURVEY OF

LOT 5, CEYLON COURT ESTATES,
CITY OF LAKE GENEVA, T1N, R17E,
WALWORTH COUNTY, WISCONSIN.

OWNER: HAROLD BACON


ACCURACY: DISTANCES ± 0.01'
ANGLES ± 05"

ERROR OF CLOSURE—LESS THAN
ONE PART IN 3000

I, HAROLD H. KOLB, DO HEREBY CERTIFY THAT I HAVE
SURVEYED THE PROPERTY HEREON DESCRIBED ACCORDING
TO THE OFFICIAL RECORDS, AND THAT THE PLAT HEREON
IS A CORRECT REPRESENTATION OF THE LOT LINES.

Harold H. Kolb

HAROLD H. KOLB
WISCONSIN REGISTERED LAND SURVEYOR, S-187
DATE Aug. 27, 1976

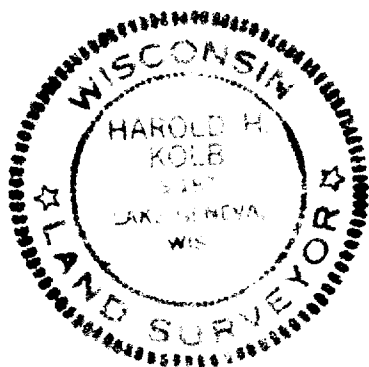

222-5

7-590