


KOLB LAND CONSULTING, INC.
LAKE GENEVA WISCONSIN

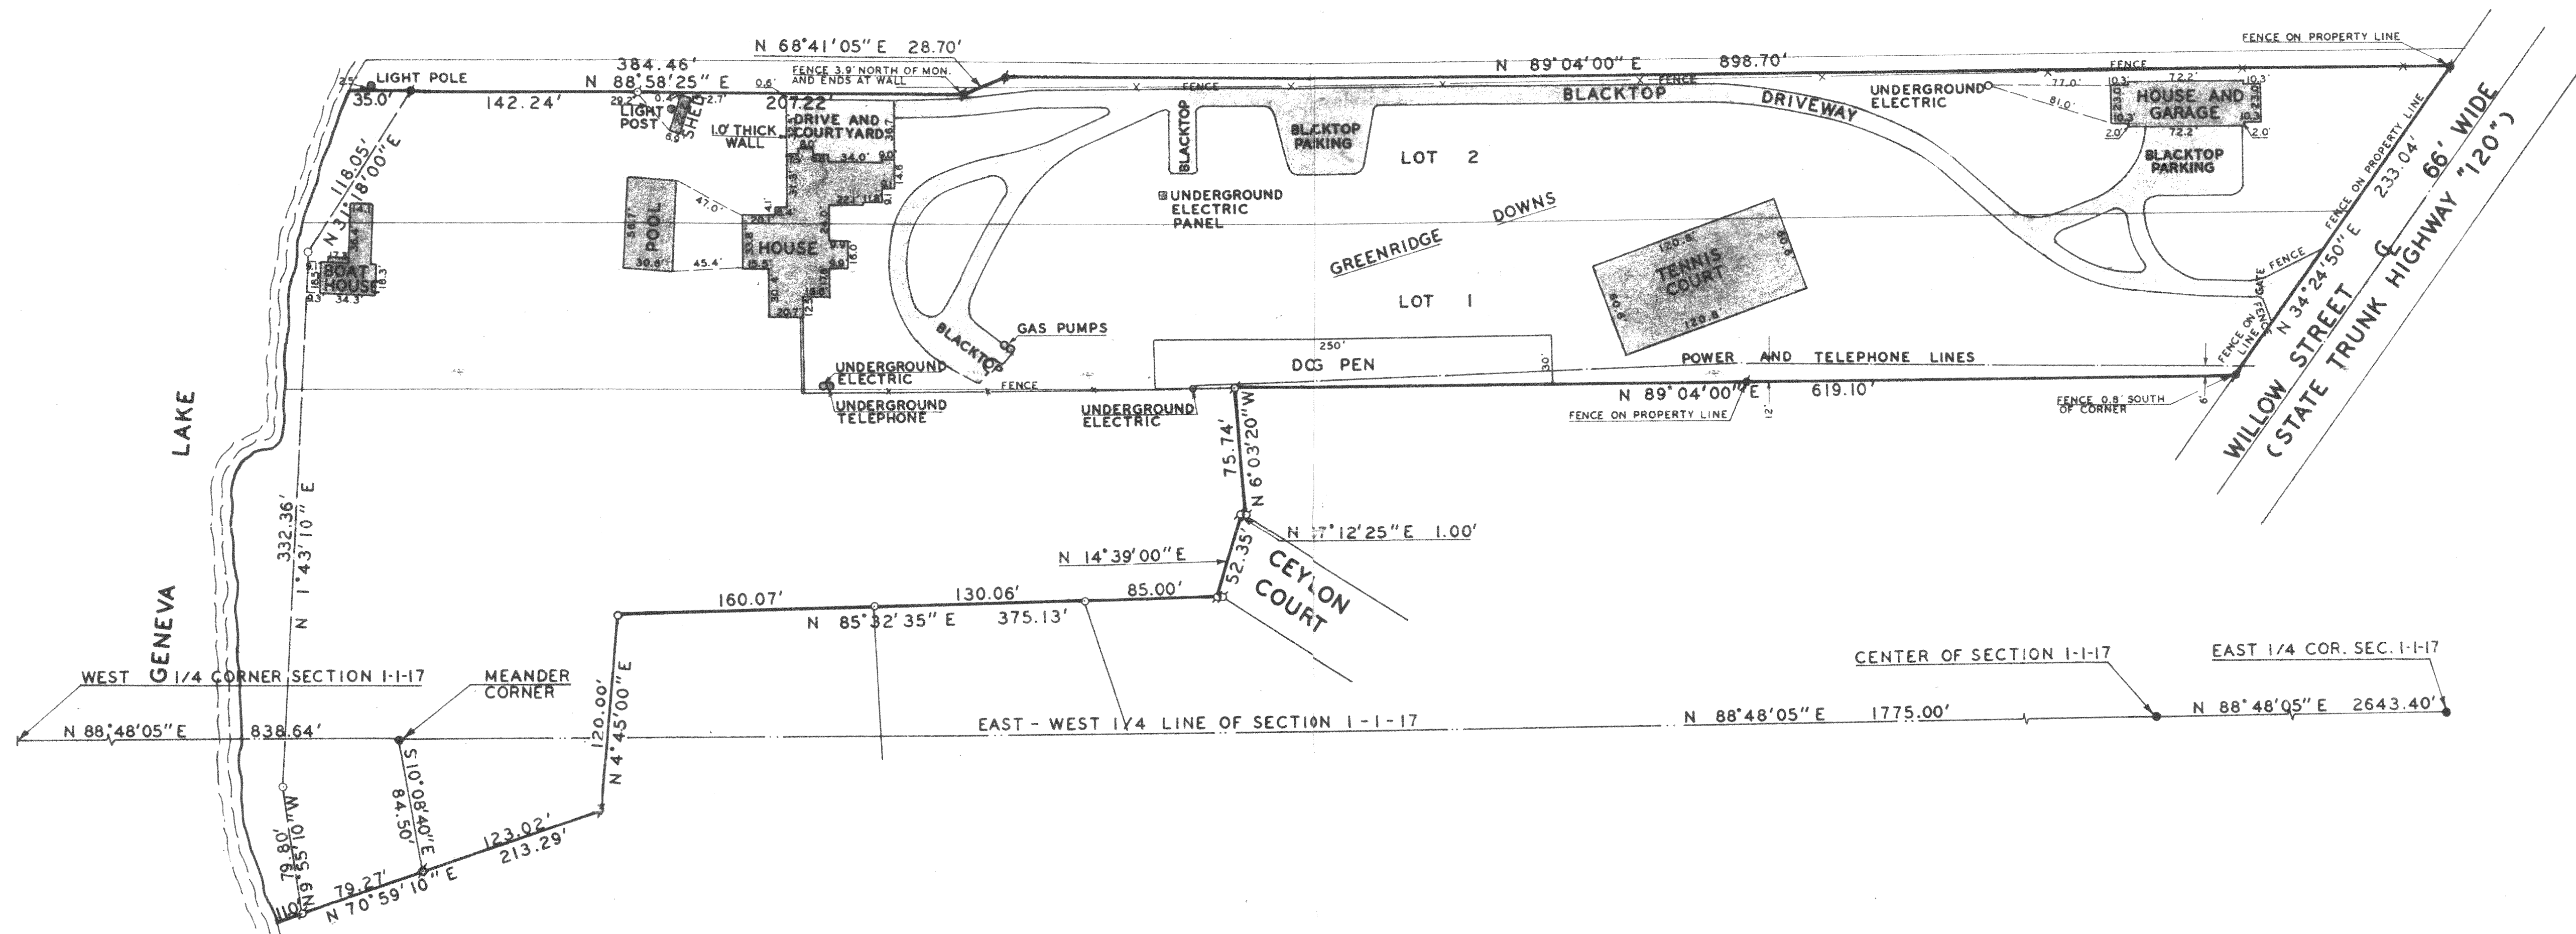

LEGEND

- IRON PIPE FOUND
- IRON PIPE PLACED
- CONCRETE MONUMENT FOUND

NOTE: BEARINGS ARE TIED TO THE
WISCONSIN STATE PLANE COORDINATE
SYSTEM-SOUTH ZONE.

PLAT OF SURVEY OF

A PARCEL OF LAND LOCATED IN THE NORTHWEST 1/4 AND
SOUTHWEST 1/4 OF SECTION 1, T1N, R17E, CITY OF LAKE
GENEVA, WALWORTH COUNTY, WISCONSIN.

ORDERED BY: BOB KEEFE AND ASSOCIATES

ACCURACY: DISTANCES $\pm 0.01'$
ANGLES $\pm 05''$
ERROR OF CLOSURE: LESS THAN
ONE PART IN 3000

N
SCALE: 1" = 60'

Harold H. Kolb
HAROLD H. KOLB
WISCONSIN REGISTERED LAND SURVEYOR, S-187
Feb. 4, 1977
DATE