


# HAROLD H. KOLB

REGISTERED PROFESSIONAL LAND SURVEYOR

LAKE GENEVA, WISCONSIN

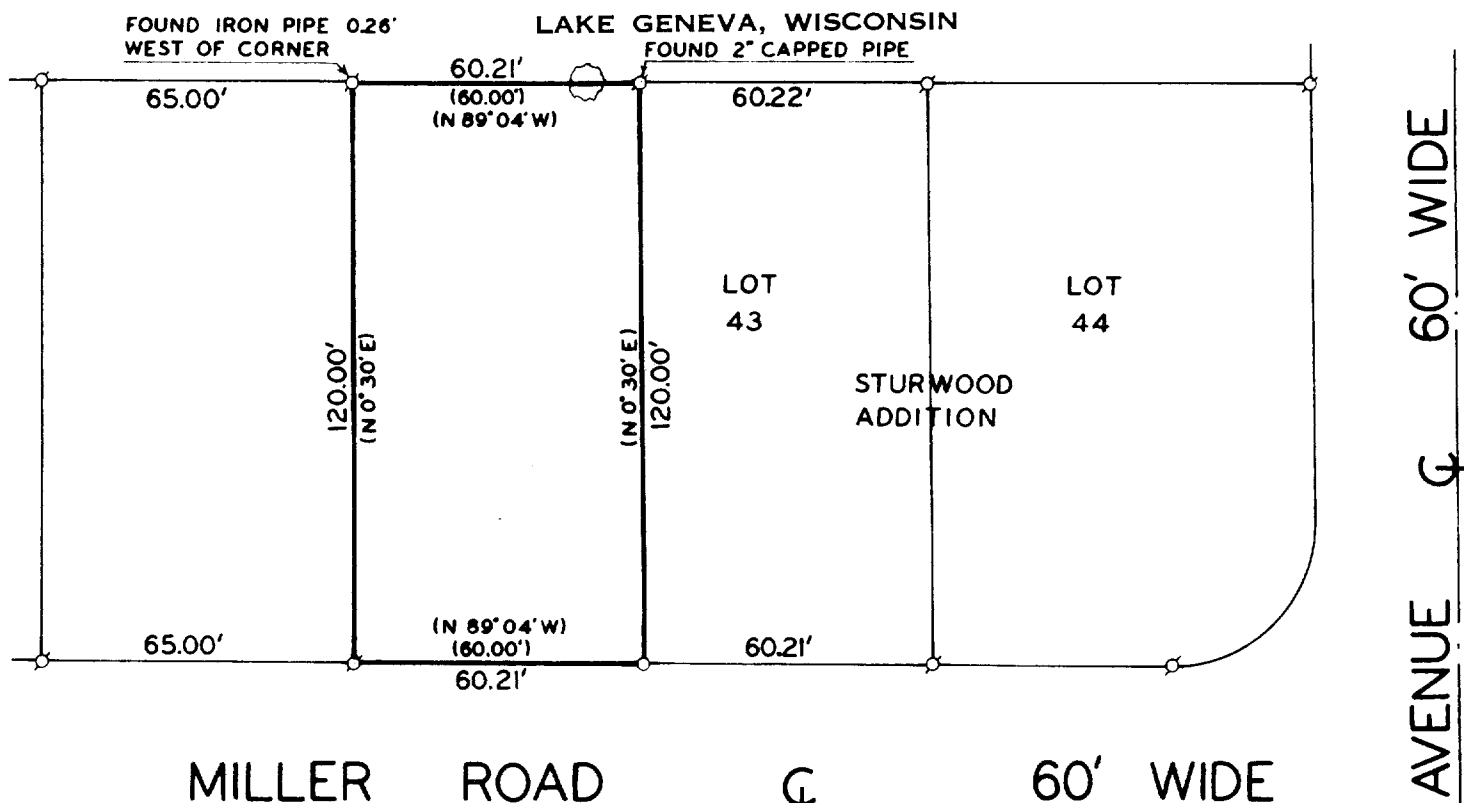

## PLAT OF SURVEY OF

A PARCEL OF LAND LOCATED IN THE NE1/4 OF SECTION 35, T2N, R17E, CITY OF LAKE GENEVA, WALWORTH COUNTY, WISCONSIN, AS DESCRIBED IN VOLUME 157, PAGE 468, RECORDS.

ACCURACY: DISTANCES  $\pm$  0.01'  
ANGLES  $\pm$  05"

ERROR OF CLOSURE- LESS THAN ONE PART IN 3000

NOTE: PROPERTY LINE IS AS MARKED ON TREE BY PAINT LINE.

OWNER: ALICE ENGELMAN



SCALE : 1" = 40'

### LEGEND

- — IRON PIPE PLACED. 1" x 24" 1.13 LB./LIN. FT.
- — CONCRETE MONUMENT, 5" DIA. x 30"
- ⊘ — IRON PIPE FOUND ( ) AS PLATTED

*Harold H. Kolb*

HAROLD H. KOLB  
WISCONSIN REGISTERED LAND SURVEYOR, S-187

DATE April 12, 1977

7-603