
## PLAT OF SURVEY

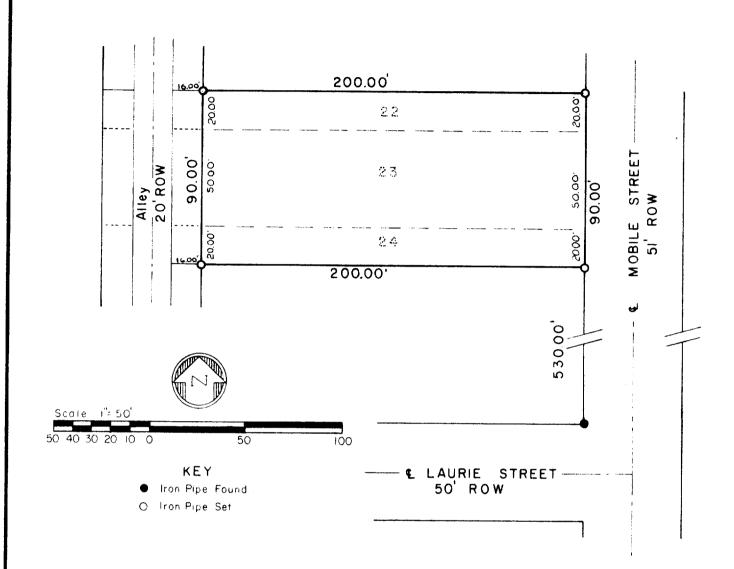

## **DESCRIPTION:**

The South 20.00 feet of Lot 22, all of Lot 23 and the North 20.00 feet of Lot 24, excluding the West 16.00 feet of the previously described lots lying in Boulevard Subdivision in the City of Lake Geneva, Walworth County, Wisconsin.

## SURVEYOR'S CERTIFICATE

I have surveyed the above described property and the above map is a true representation thereof and shows the size and location of the property, its exterior boundaries, the location and dimensions of all visible encroachments. This survey is made for the exclusive use of the present owners of the property, and also those who purchase, mortgage, or guarantee the title thereto within one (1) year from date hereof and as to them I warrant the accuracy of said survey and map.

Date May 25, 1978

Dennis W. Valentine, RLS 1419

ZBL-21

Prepared By
VALENTINE AND ASSOCIATES, INC.

DELAVAN, WISCONSIN

Prepared For

BEA DALE LAKE GENEVA, WISCONSIN Date 5/25/75 Job Number 7855 Sheet Number
of |
Reference

5 File

フーム3フ