


KOLB LAND CONSULTING, INC.
LAND SURVEYING • SUBDIVIDING • LAND PLANNING

LAKE GENEVA, WISCONSIN 53147

WHITEWATER, WISCONSIN 53190

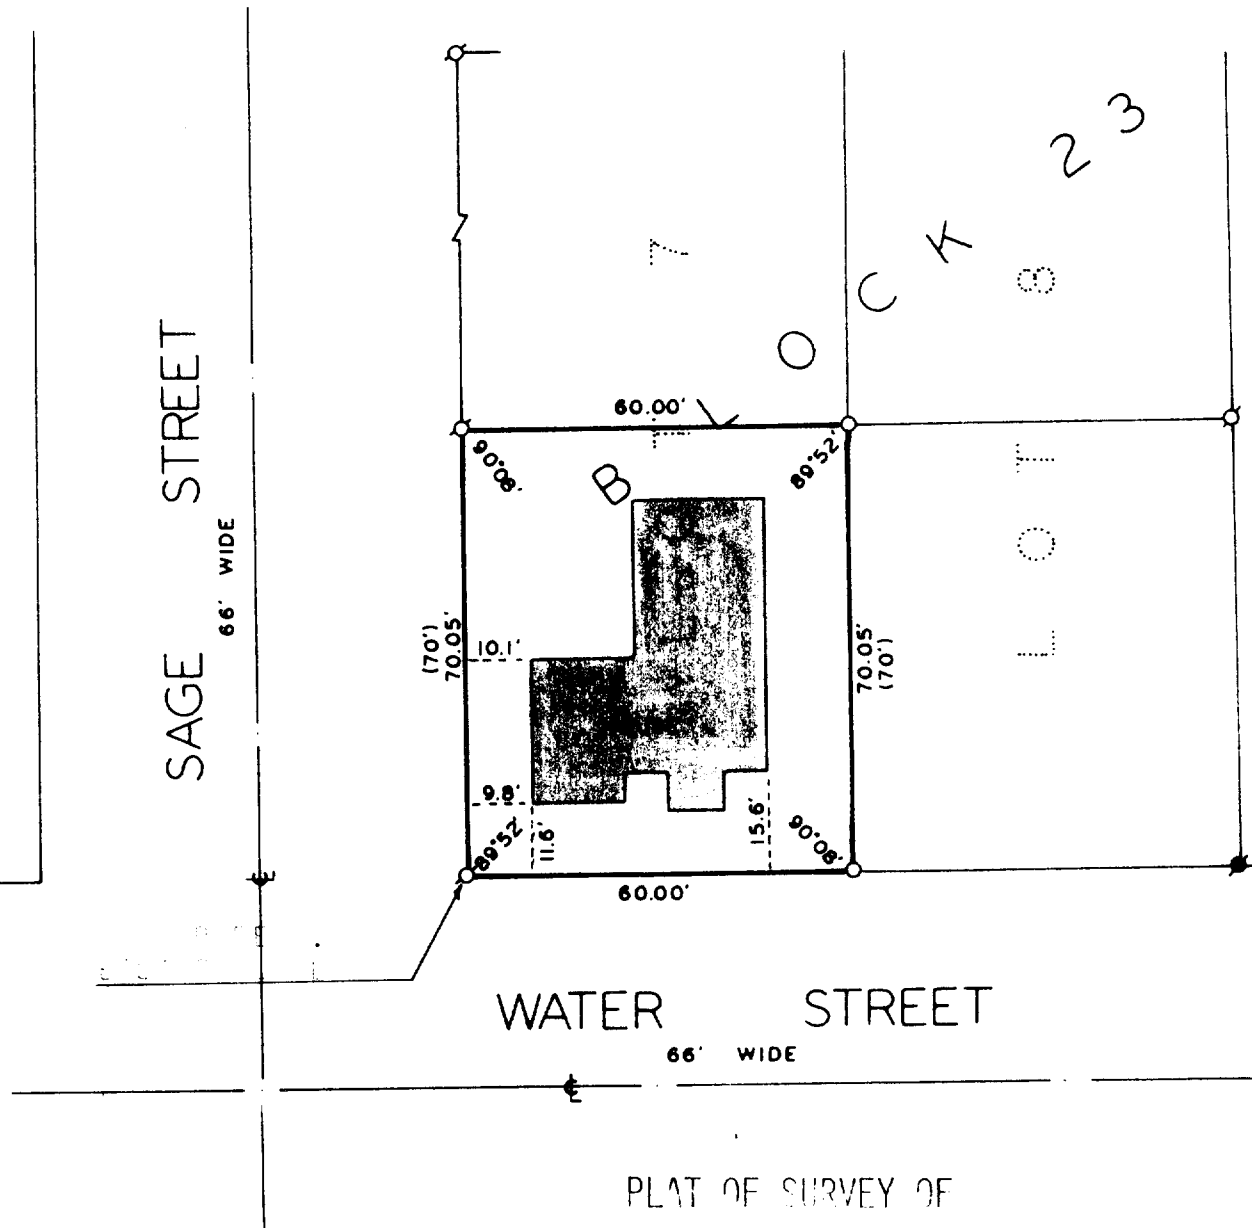

THE SOUTH 70 FEET OF LOT 7, BLOCK 23, GENEVA
LAKE CRAWFORD MANUFACTURING COMPANY'S ADDITION
TO THE CITY OF LAKE GENEVA, WALWORTH COUNTY,
WISCONSIN.

ORDERED BY: STEVEN MALSCH
533 WATER STREET
LAKE GENEVA, WI 53147



I, HAROLD H. KOLB, DO HEREBY CERTIFY THAT I HAVE
SURVEYED THE PROPERTY HEREON DESCRIBED ACCORDING
TO THE OFFICIAL RECORDS, AND THAT THE PLAT HEREON
IS A CORRECT REPRESENTATION OF THE LOT LINES.

Harold H. Kolb

WISCONSIN REGISTERED LAND SURVEYOR, S-
DATE 10/1/87

26C-137

7-642K^v