
## HAROLD H. KOLB

REGISTERED PROFESSIONAL LAND SURVEYOR LAKE GENEVA, WISCONSIN



I, EUGENE A. BLOMQUIST, DO HEREBY CERTIFY THAT I HAVE SURVEYED THE PROPERTY HEREON DESCRIBED ACCORDING TO THE OFFICIAL RECORDS AND THAT THE PLAT HEREON IS A CORRECT RE-PRESENTATION OF THE LOT LINES.

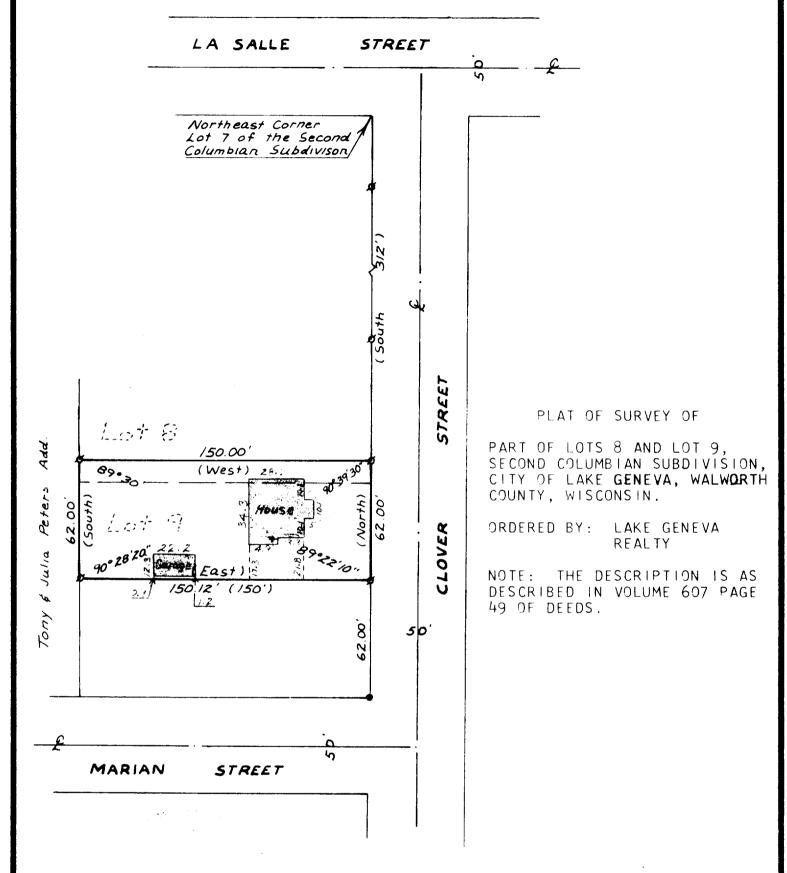

Scale · /" = 50"

LEGEND

O - IRON PIPE PLACED, 1" x 24" 1.13 LB./LIN. FT.

- IRON PIPE FOUND

CONCRETE MONUMENT, 5" DIA. x 30"

EUGENE A BLOMQUIST WISCONSIN REGISTERED LAND SURVEYOR, S-1279

Feb. 23 1478 DATE

REVISED: FEB. 24, 1978