


# HAROLD H. KOLB


REGISTERED PROFESSIONAL LAND SURVEYOR  
LAKE GENEVA, WISCONSIN

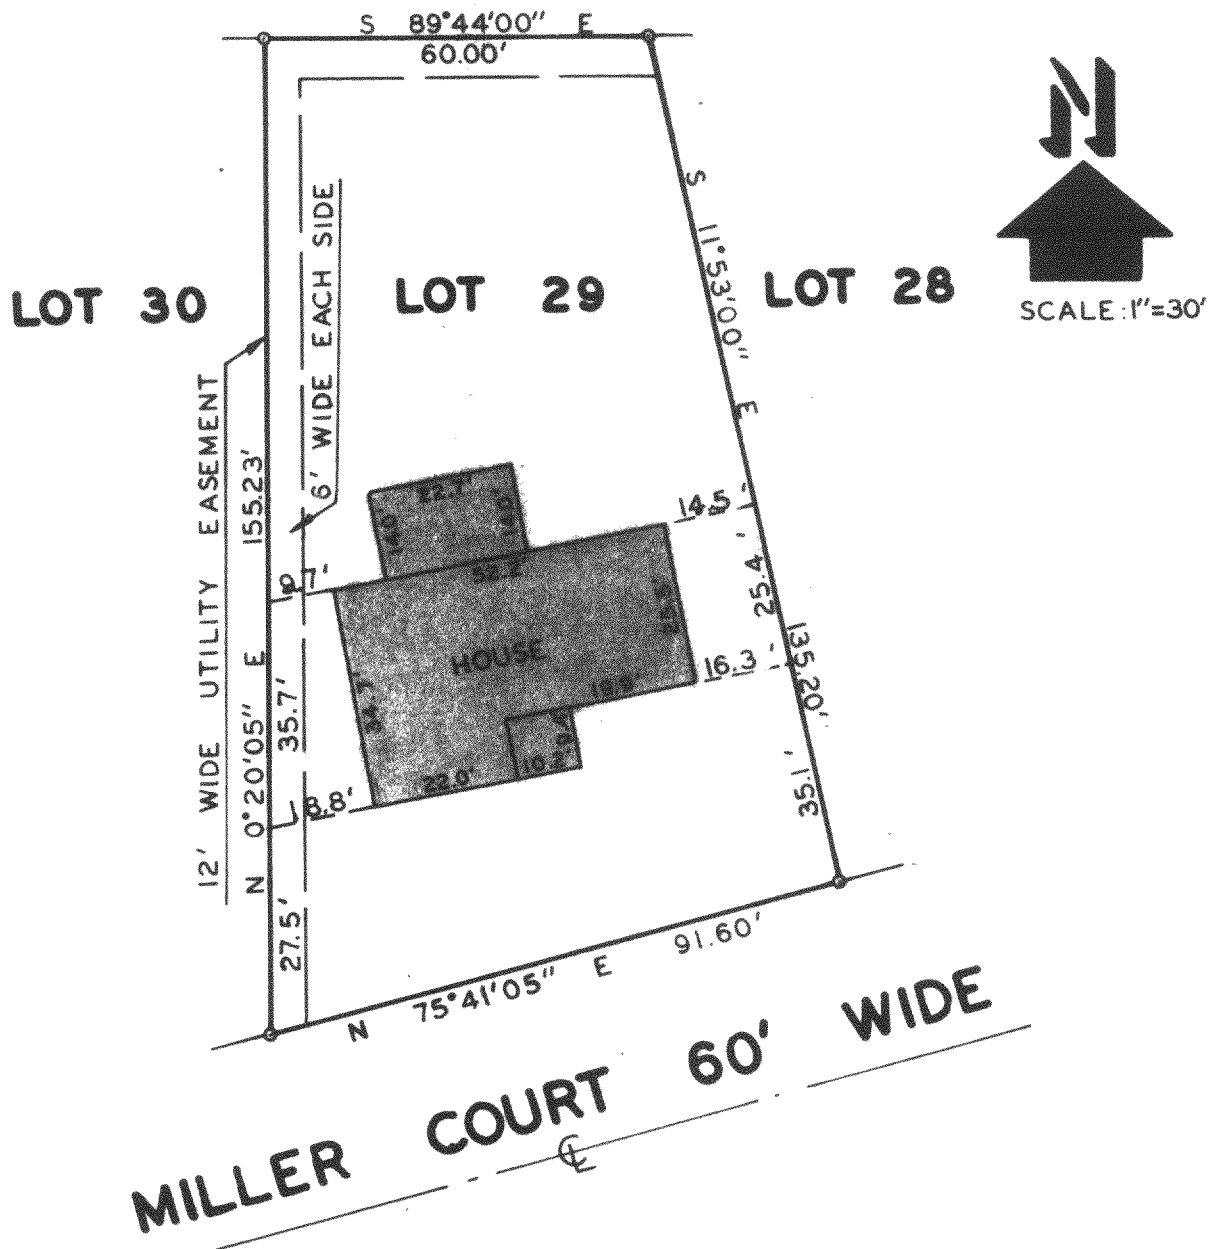

A PLAT OF SURVEY OF

LOT 29 OF WESTGATE SUBDIVISION, CITY  
OF LAKE GENEVA, WALWORTH COUNTY, STATE  
OF WISCONSIN.

ORDERED BY: VINCENT PUSATERI  
1743 MILLER DRIVE  
LAKE GENEVA, WI 53147

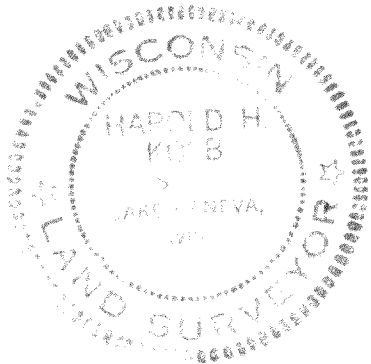

I, HAROLD H. KOLB, DO HEREBY CERTIFY THAT I HAVE  
SURVEYED THE PROPERTY HEREON DESCRIBED ACCORDING  
TO THE OFFICIAL RECORDS AND THAT THE PLAT HEREON  
IS A CORRECT REPRESENTATION OF THE LOT LINES.

*Harold H. Kolb*

HAROLD H. KOLB  
WISCONSIN REGISTERED LAND SURVEYOR, S-187

DATE AUG 24, 1978

REVISED: SEPTEMBER 20, 1978

## LEGEND

O — IRON PIPE FOUND