


HAROLD H. KOLB
 REGISTERED PROFESSIONAL LAND SURVEYOR
 LAKE GENEVA, WISCONSIN

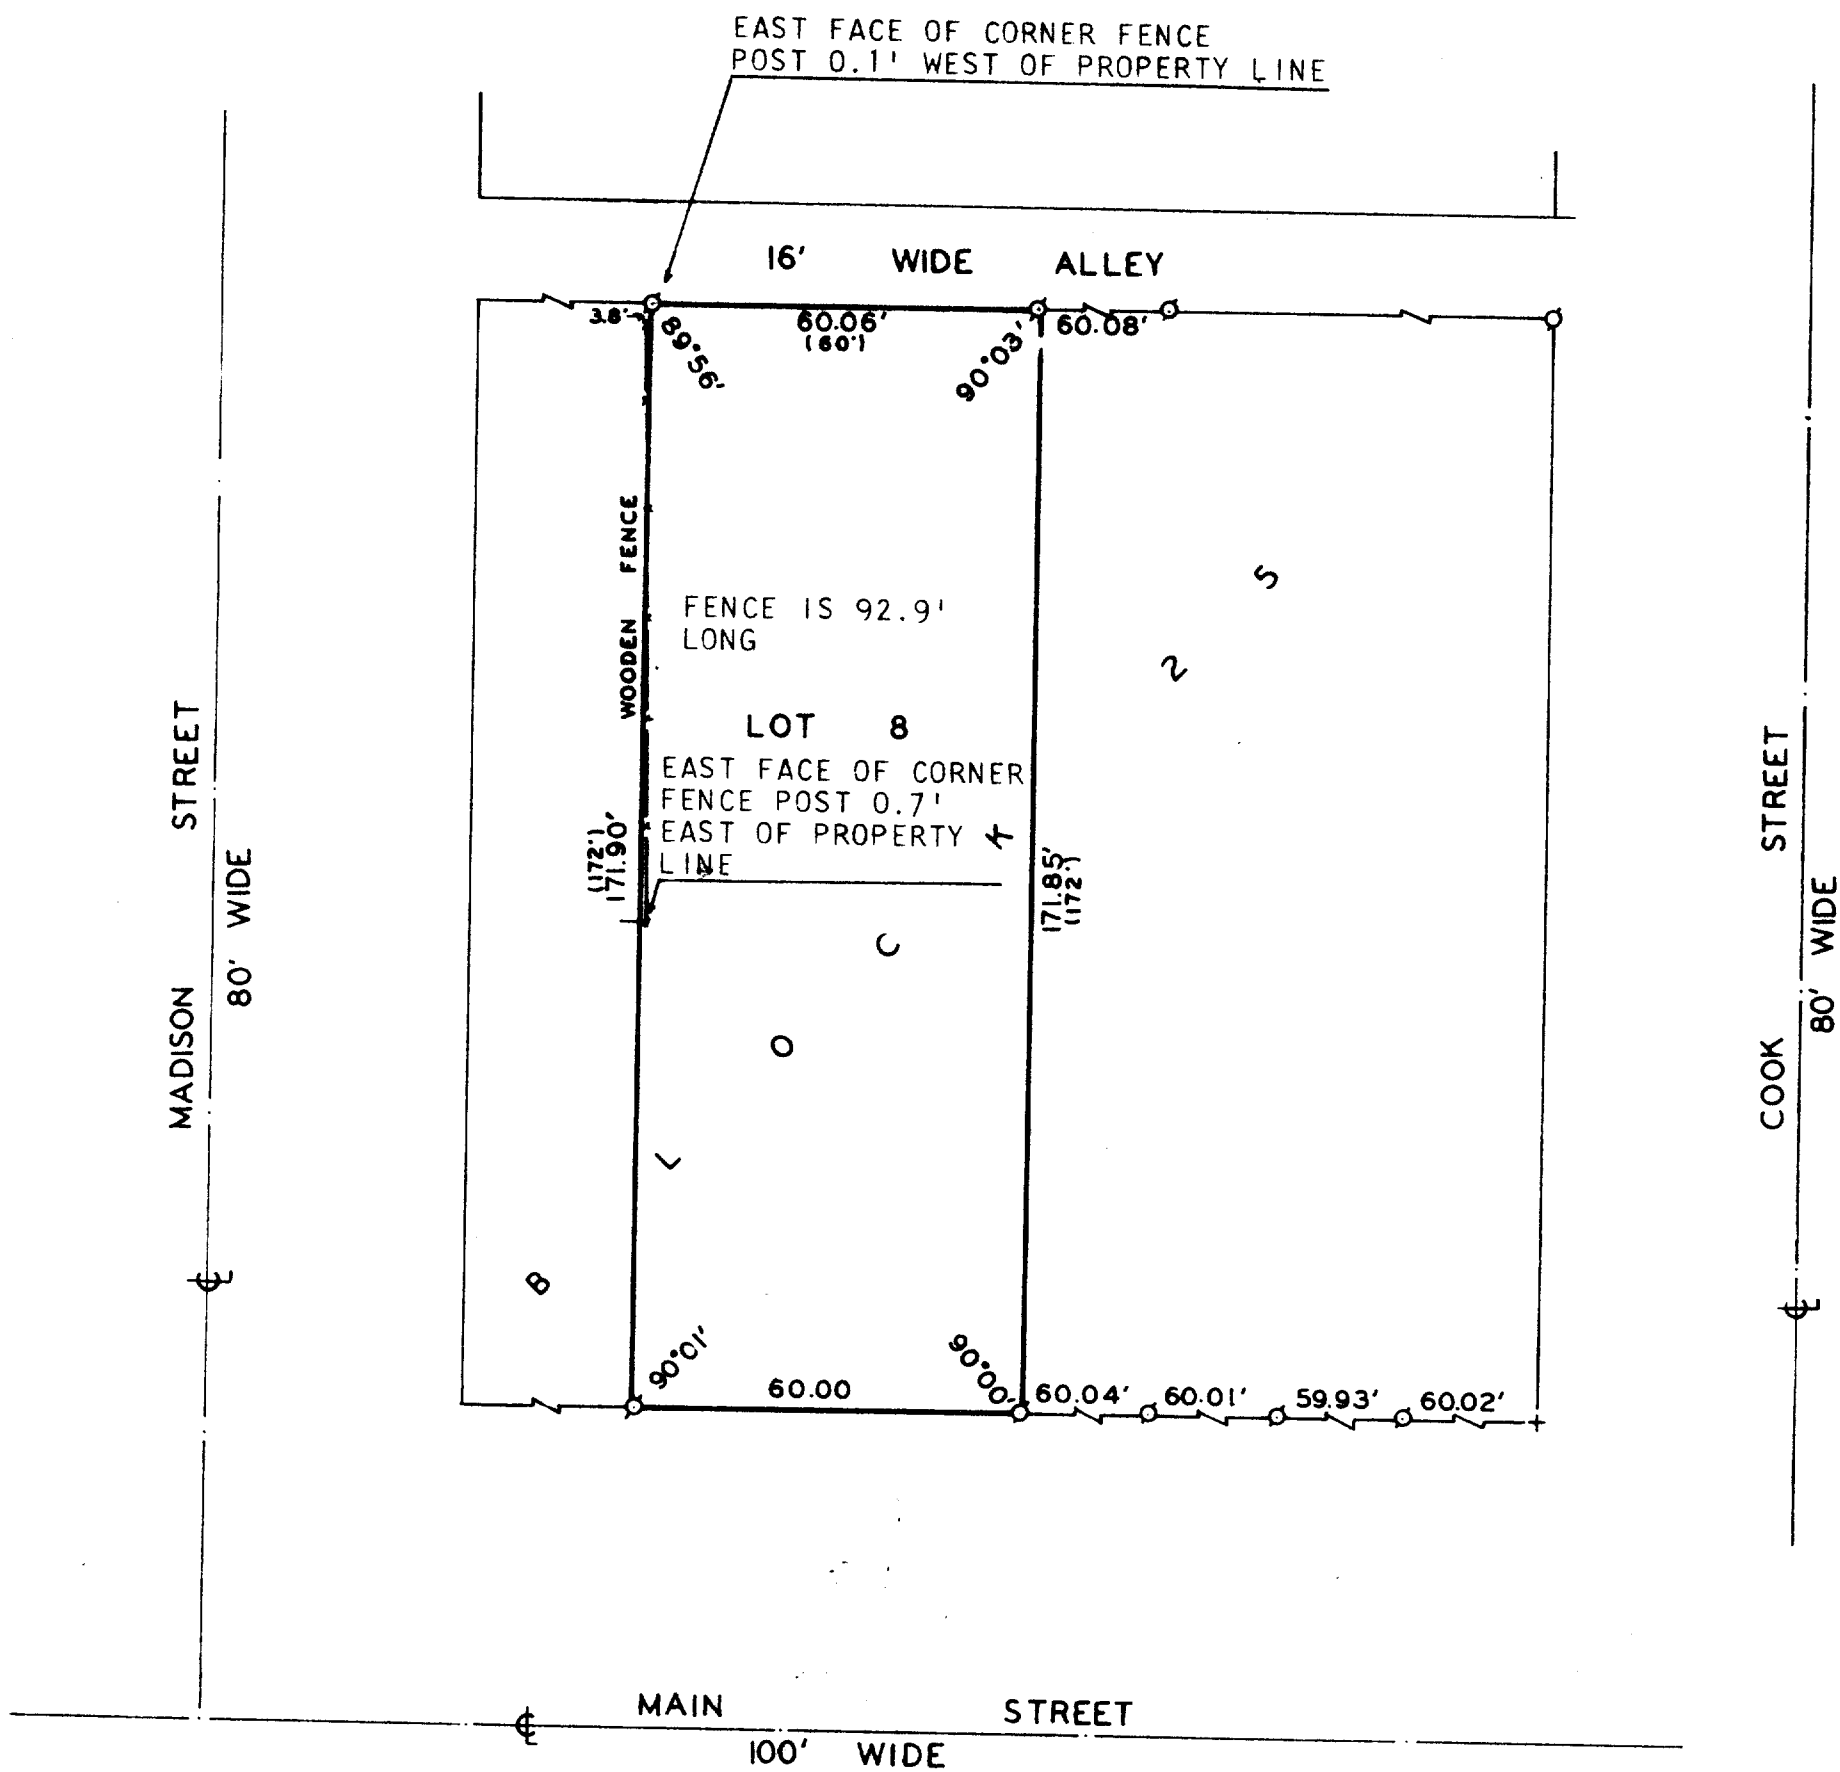

PLAT OF SURVEY OF
 LOT 8, BLOCK 25, ORIGINAL PLAT OF THE CITY OF LAKE GENEVA,
 WALWORTH COUNTY, WISCONSIN.


ORDERED BY: MRS. GERMAINE WILLIAMS
 927 MAIN STREET
 LAKE GENEVA, WIS. 53147



SCALE: 1"=30'

LEGEND

- φ - IRON PIPE FOUND
- - IRON PIPE PLACED
- - CONCRETE MONUMENT
- x - SPIKE
- + - CUT CROSS FOUND
- () - AS PLATTED

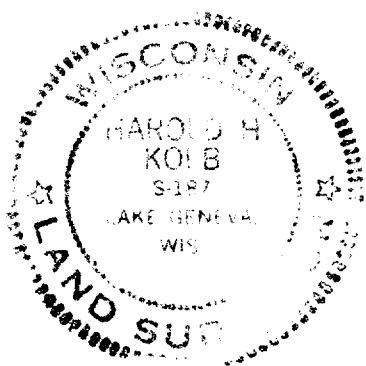

I, HAROLD H. KOLB, DO HEREBY CERTIFY THAT I HAVE
 SURVEYED THE PROPERTY HEREON DESCRIBED ACCORDING
 TO THE OFFICIAL RECORDS, AND THAT THE PLAT HEREON
 IS A CORRECT REPRESENTATION OF THE LOT LINES.

Harold H. Kolb
 HAROLD H. KOLB
 WISCONSIN REGISTERED LAND SURVEYOR, S-187
 DATE May 12, 1978