



KOLB LAND CONSULTING, INC.  
 LAND SURVEYING • SUBDIVIDING • LAND PLANNING

LAKE GENEVA, WISCONSIN 53147

WHITEWATER, WISCONSIN 53190

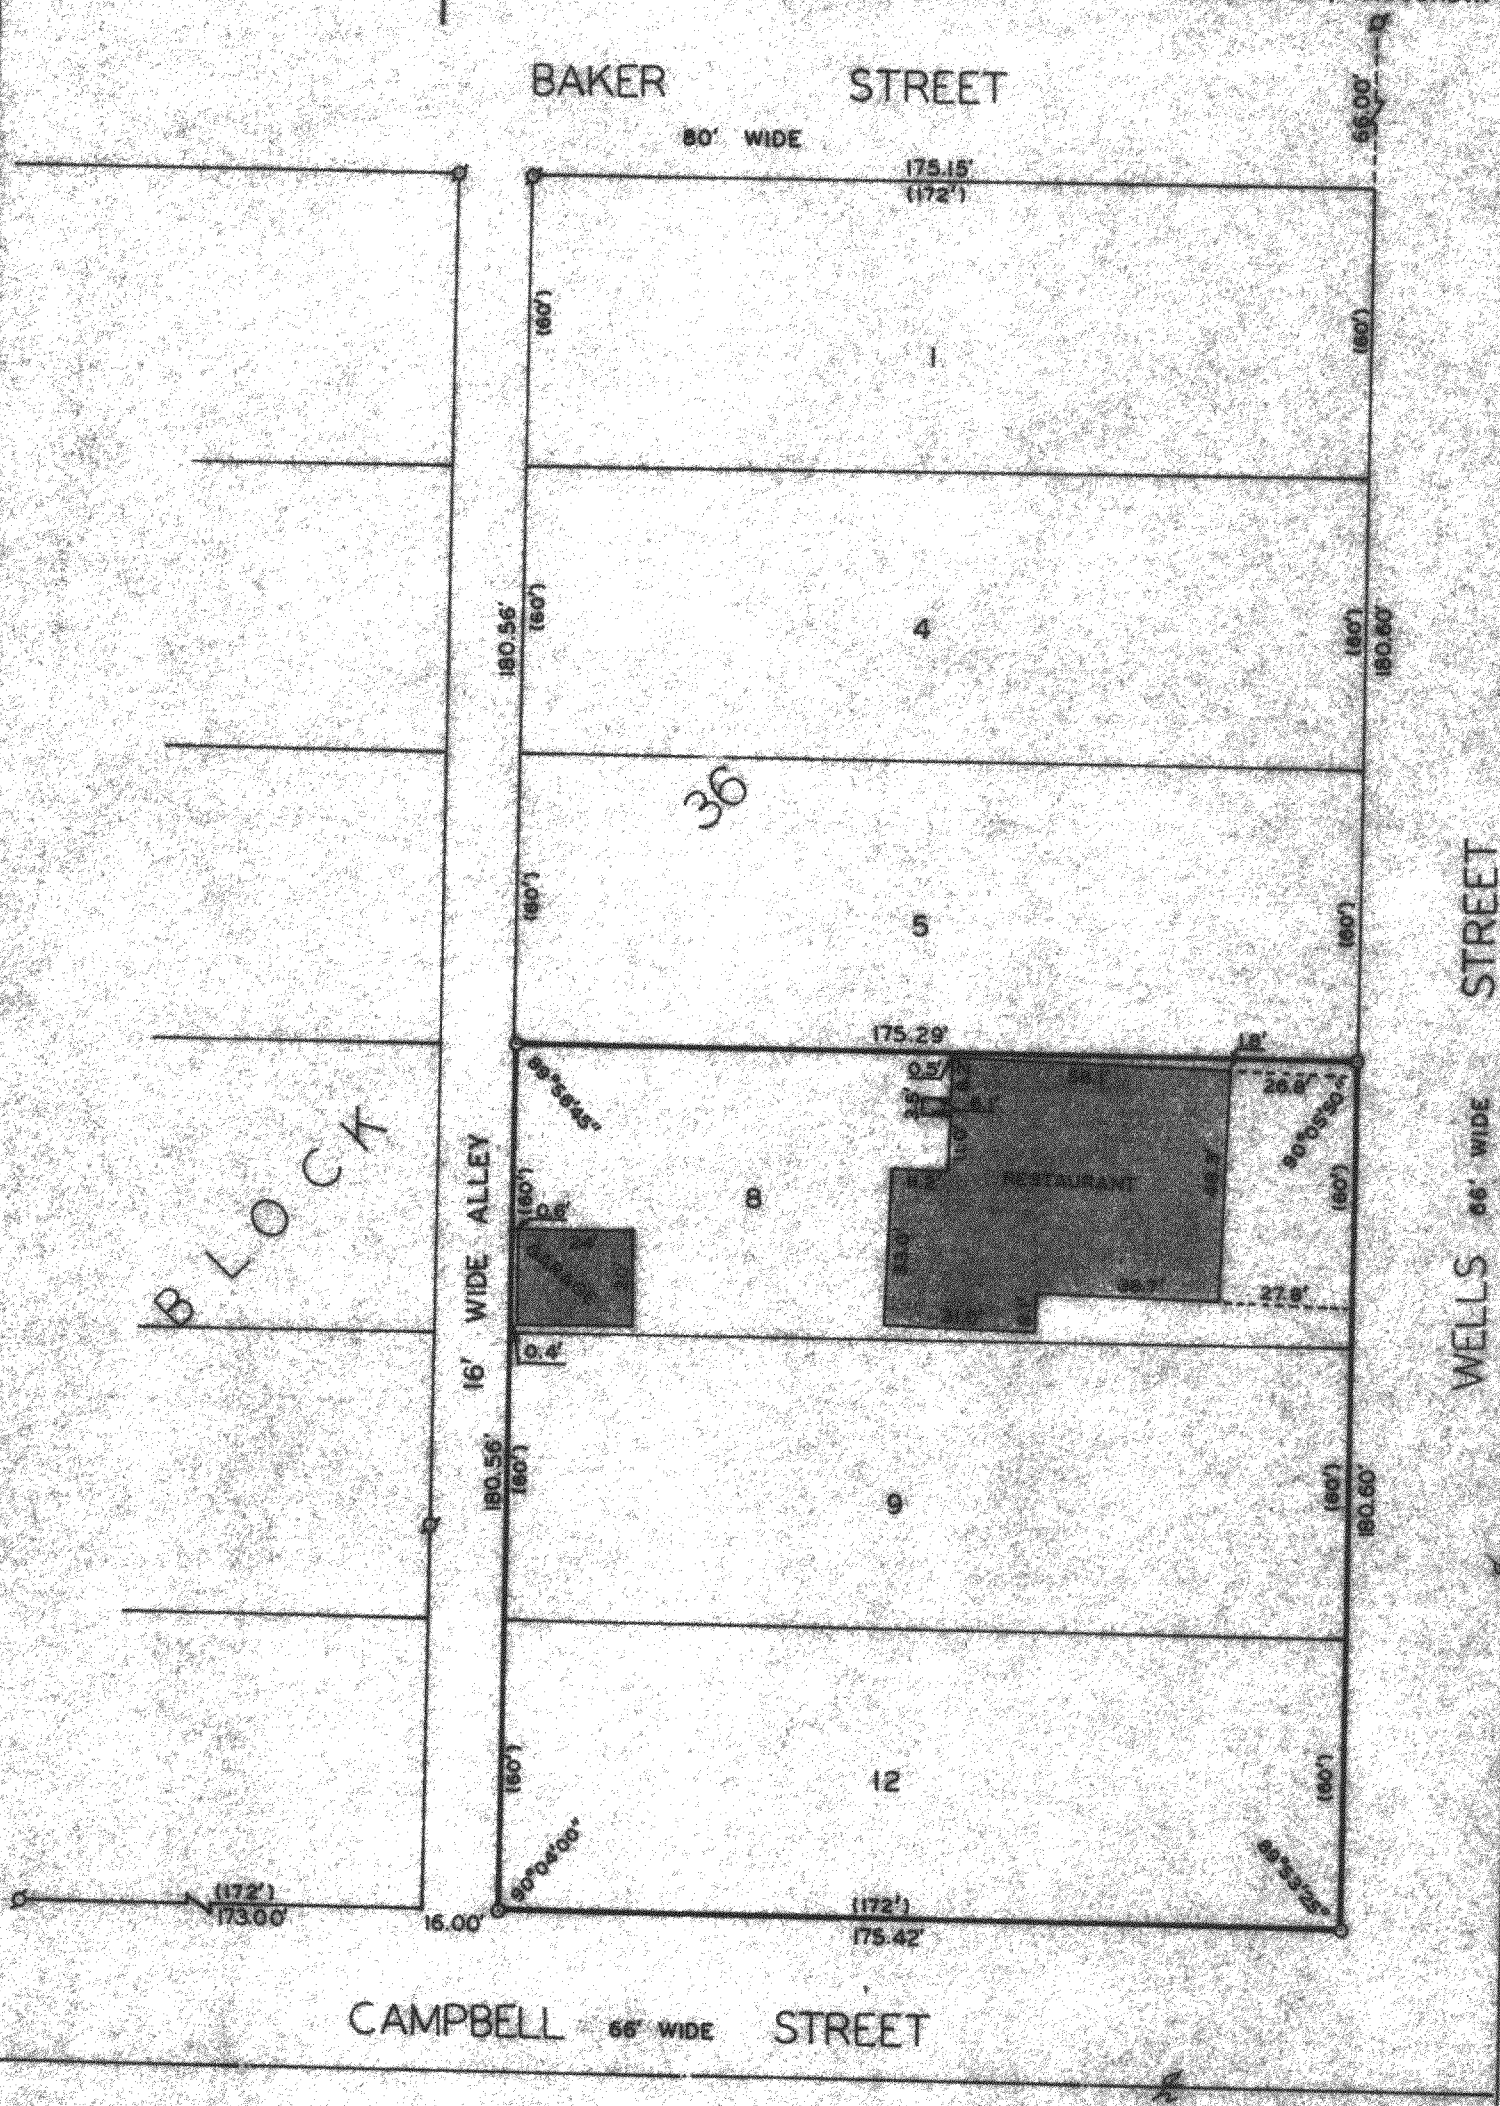

PLAT OF SURVEY OF  
 LOTS 8, 9 AND 12, BLOCK 36, ORIGINAL PLAT, CITY OF  
 LAKE GENEVA, WALWORTH COUNTY, WISCONSIN.  
 OWNER: FRANK FAZIO  
 422 WELLS STREET  
 LAKE GENEVA, WI 53147

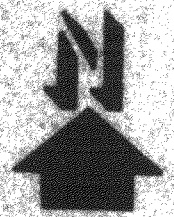

LEGEND  
 SCALE: 1" = 40'  
 ♂ - IRON PIPE FOUND  
 ○ - IRON PIPE PLACED  
 ( ) - RECORDED AS



I, HAROLD H. KOLB, DO HEREBY CERTIFY THAT I HAVE  
 SURVEYED THE PROPERTY HEREON DESCRIBED ACCORDING  
 TO THE OFFICIAL RECORDS, AND THAT THE PLAT HEREON  
 IS A CORRECT REPRESENTATION OF THE LOT LINES, TO  
 THE BEST OF MY KNOWLEDGE AND BELIEF.  
*Harold H. Kolb*  
 HAROLD H. KOLB  
 WISCONSIN REGISTERED LAND SURVEYOR, S-187  
 DATE July 29, 1980

ZOP-34

7-694-K