


45-10

**DESCRIPTION:**

Lot 25 Block 31, Lake Geneva Manor a subdivision of a portion of the Village (now city) of Lake Geneva Walworth County, Wisconsin.

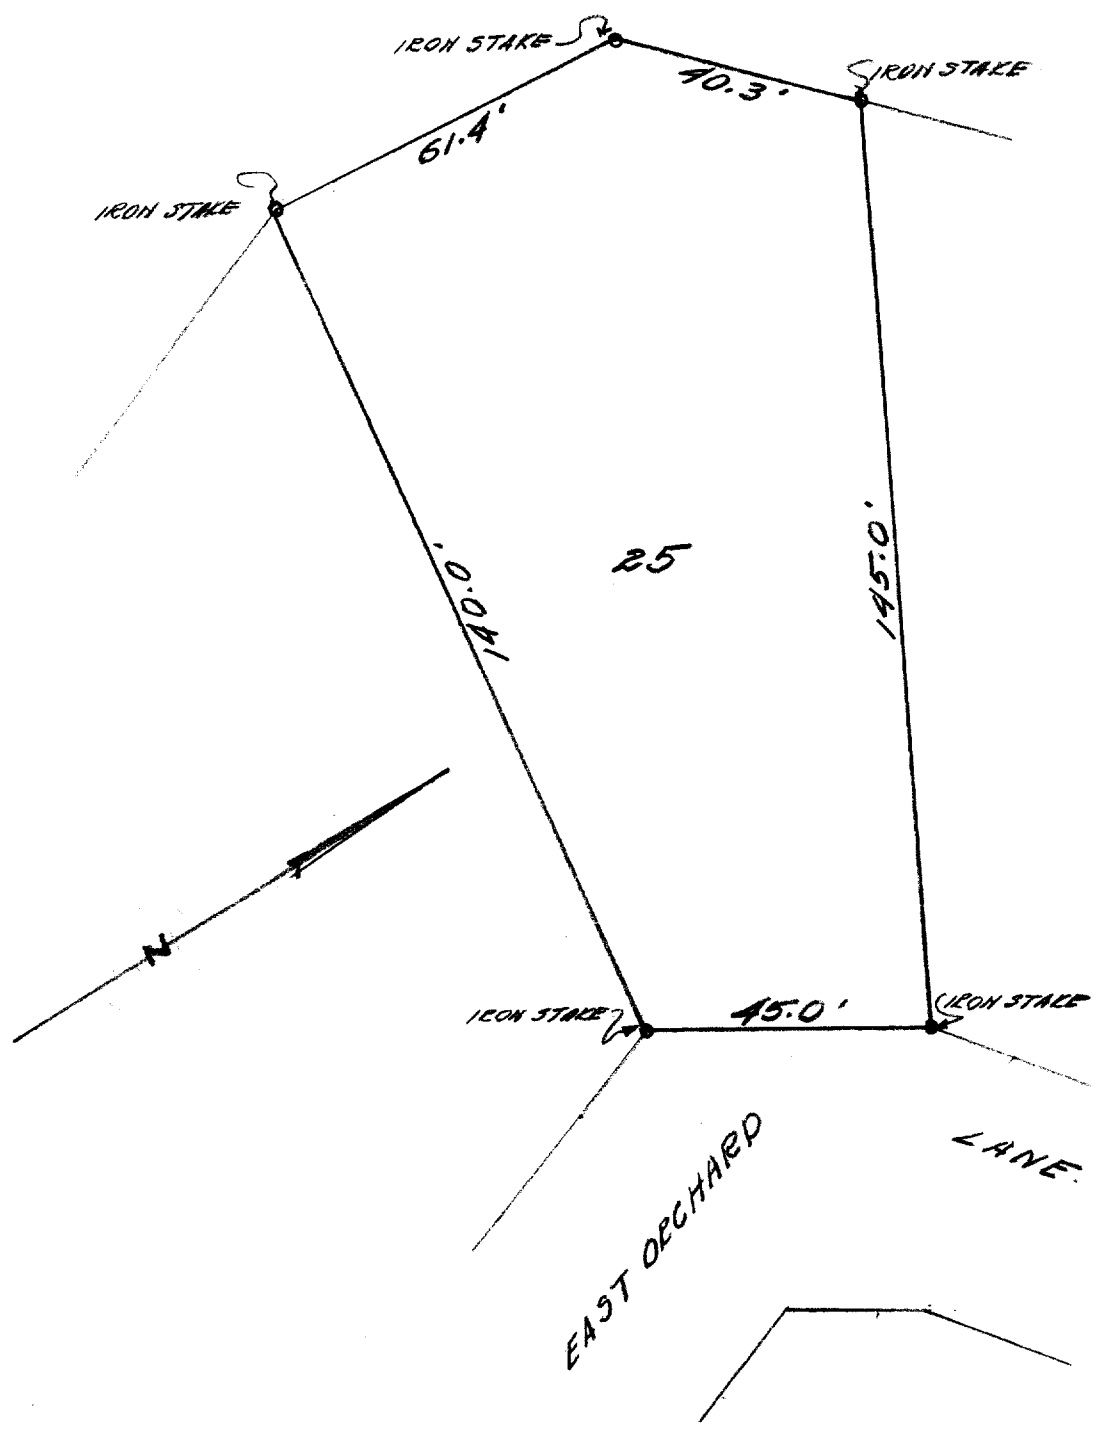

**CERTIFICATE:**

I, hereby certify that I have on this the 14th day of May, 1945, surveyed the above described property according to the official records on file in the office of the Recorder of Deeds in and for Walworth County, Wisconsin, and find that no encroachments exist, and that the plat hereon portrayed is an exact representation of the conditions found at the site on this day.

SIGNED AND SEALED THIS 15th DAY OF MAY 1945.

*Joseph M. Biagi*  
Joseph M. Biagi. Professional Engineer  
Elkhorn Wisconsin.

50

ZLM ES

7-70B