


KOLB LAND CONSULTING, INC.  
LAKE GENEVA, WISCONSIN

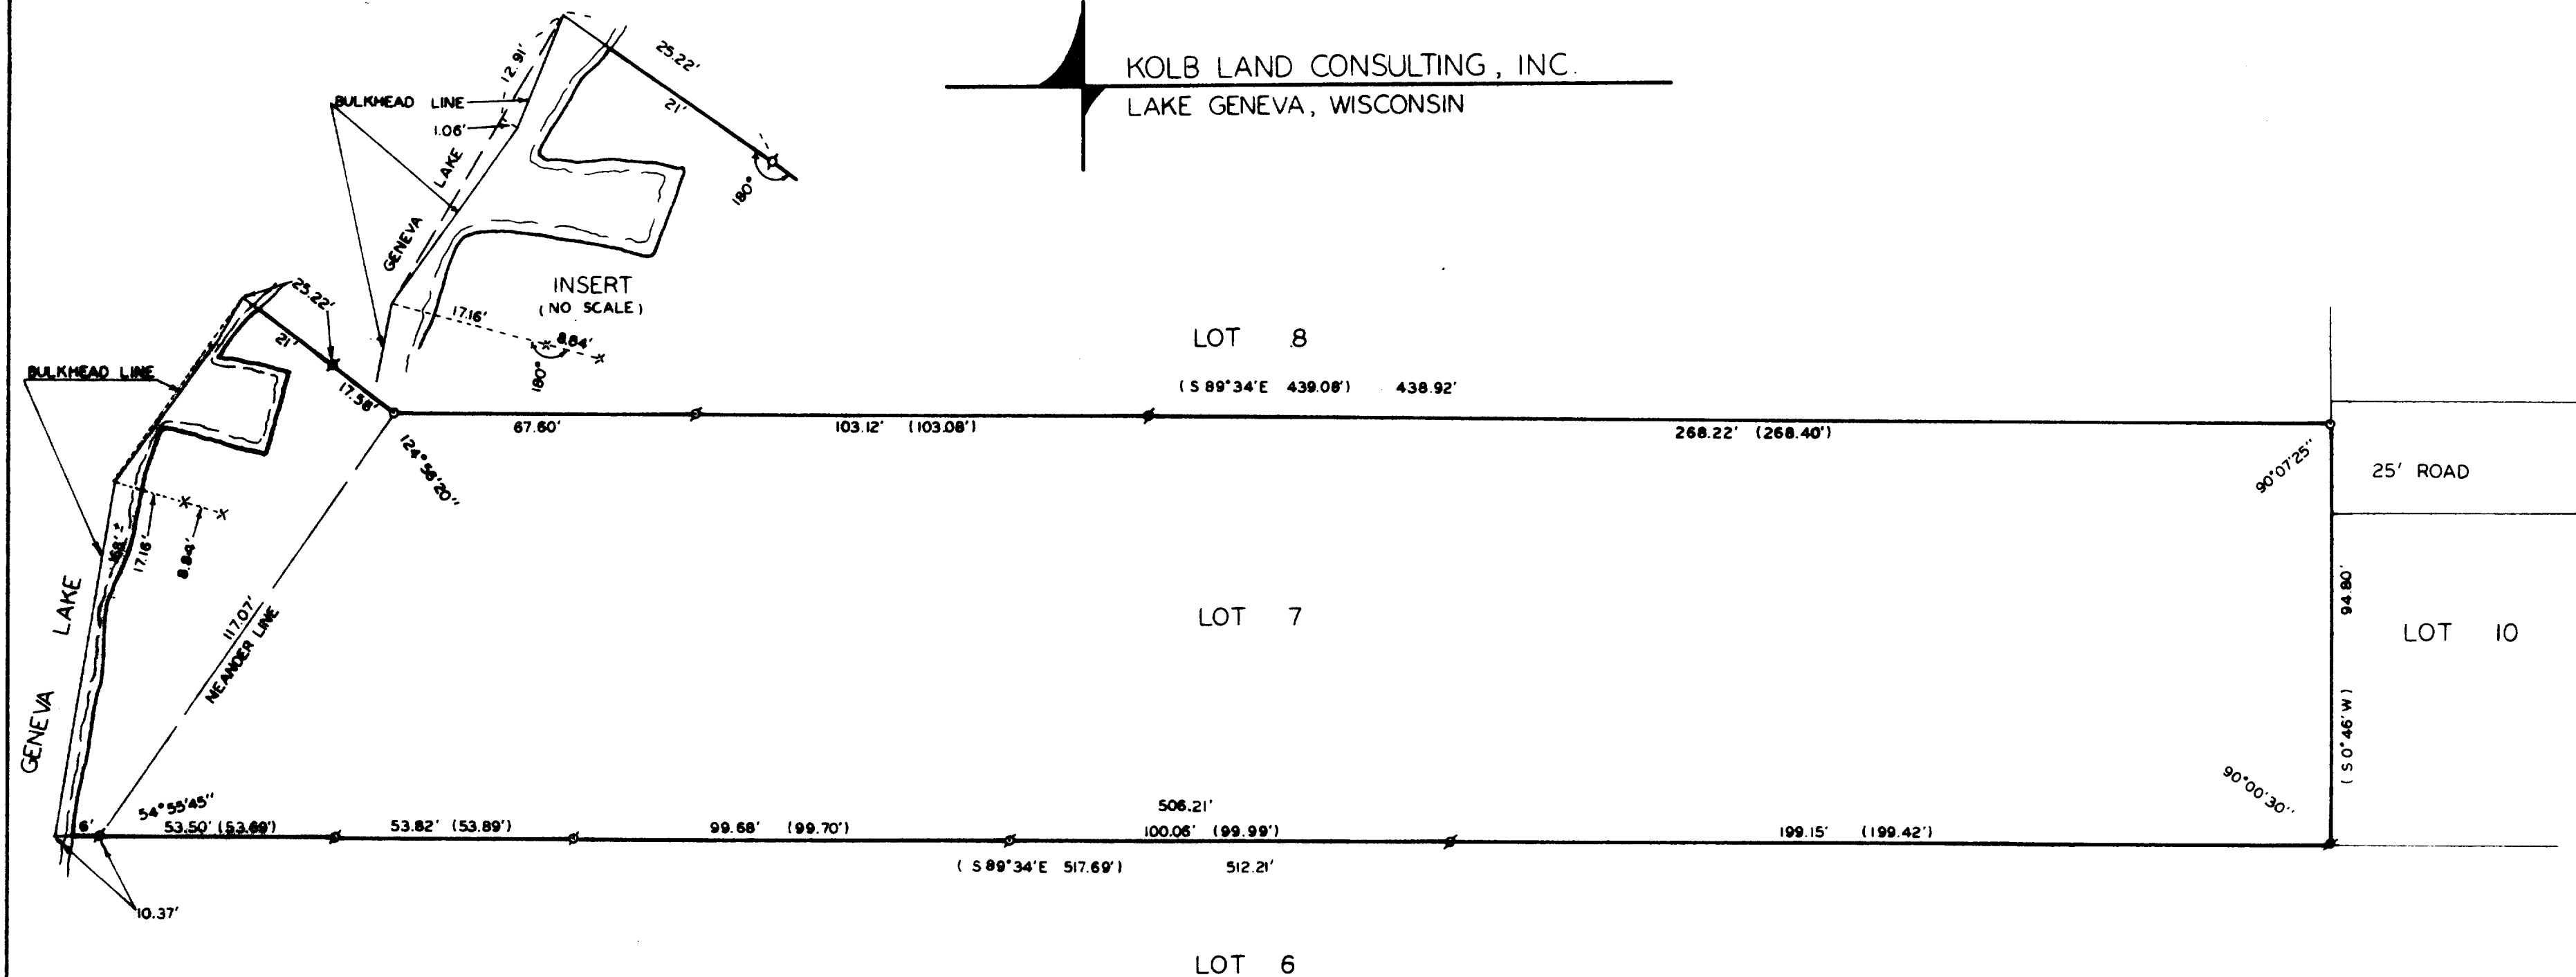

PLAT OF SURVEY OF


LOT 7 OF GREENRIDGE DOWNS, A SUBDIVISION LOCATED IN THE  
CITY OF LAKE GENEVA, WALWORTH COUNTY, WISCONSIN.

OWNER: VERNA BEZAZIAN  
1945 NORTH LATORBE AVE.  
CHICAGO, IL 60639



SCALE - 1"=30'

- LEGEND
- ⊕ - IRON PIPE FOUND
  - - CONCRETE MONUMENT FOUND
  - - IRON PIPE SET
  - ( ) - RECORDED AS OR AS PLATTED
  - x - 12" SPIKE SET

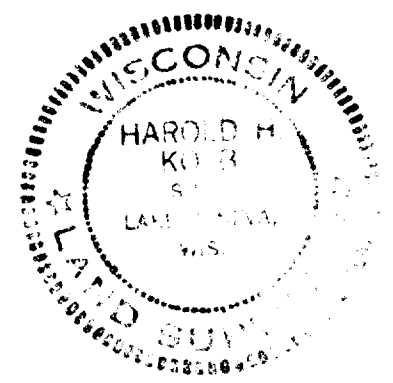

I, HAROLD H. KOLB, DO HEREBY CERTIFY  
THAT I HAVE SURVEYED THE PROPERTY  
HEREON DESCRIBED ACCORDING TO THE  
OFFICIAL RECORDS, AND THAT THE PLAT  
HEREON IS A CORRECT REPRESENTATION  
OF THE LOT LINES TO THE BEST OF MY  
KNOWLEDGE AND BELIEF.

*Harold H. Kolb*  
HAROLD H. KOLB  
WISCONSIN REGISTERED LAND SURVEYOR, S-187

DATE Nov 18, 1981

ZGR-4

7-710K