


KOLB LAND CONSULTING, INC.
LAND SURVEYING • SUBDIVIDING • LAND PLANNING

LAKE GENEVA, WISCONSIN 53147

WHITEWATER, WISCONSIN 53190

NOTE: BEARINGS USED ARE AS SHOWN ON THE RECORDED PLAT OF WESTGATE SUBDIVISION.
AT POINTS "A" & "B" FOUND IRON PIPE DOWN 1.5 FEET, SET NEW IRON PIPE AT GROUND LEVEL.

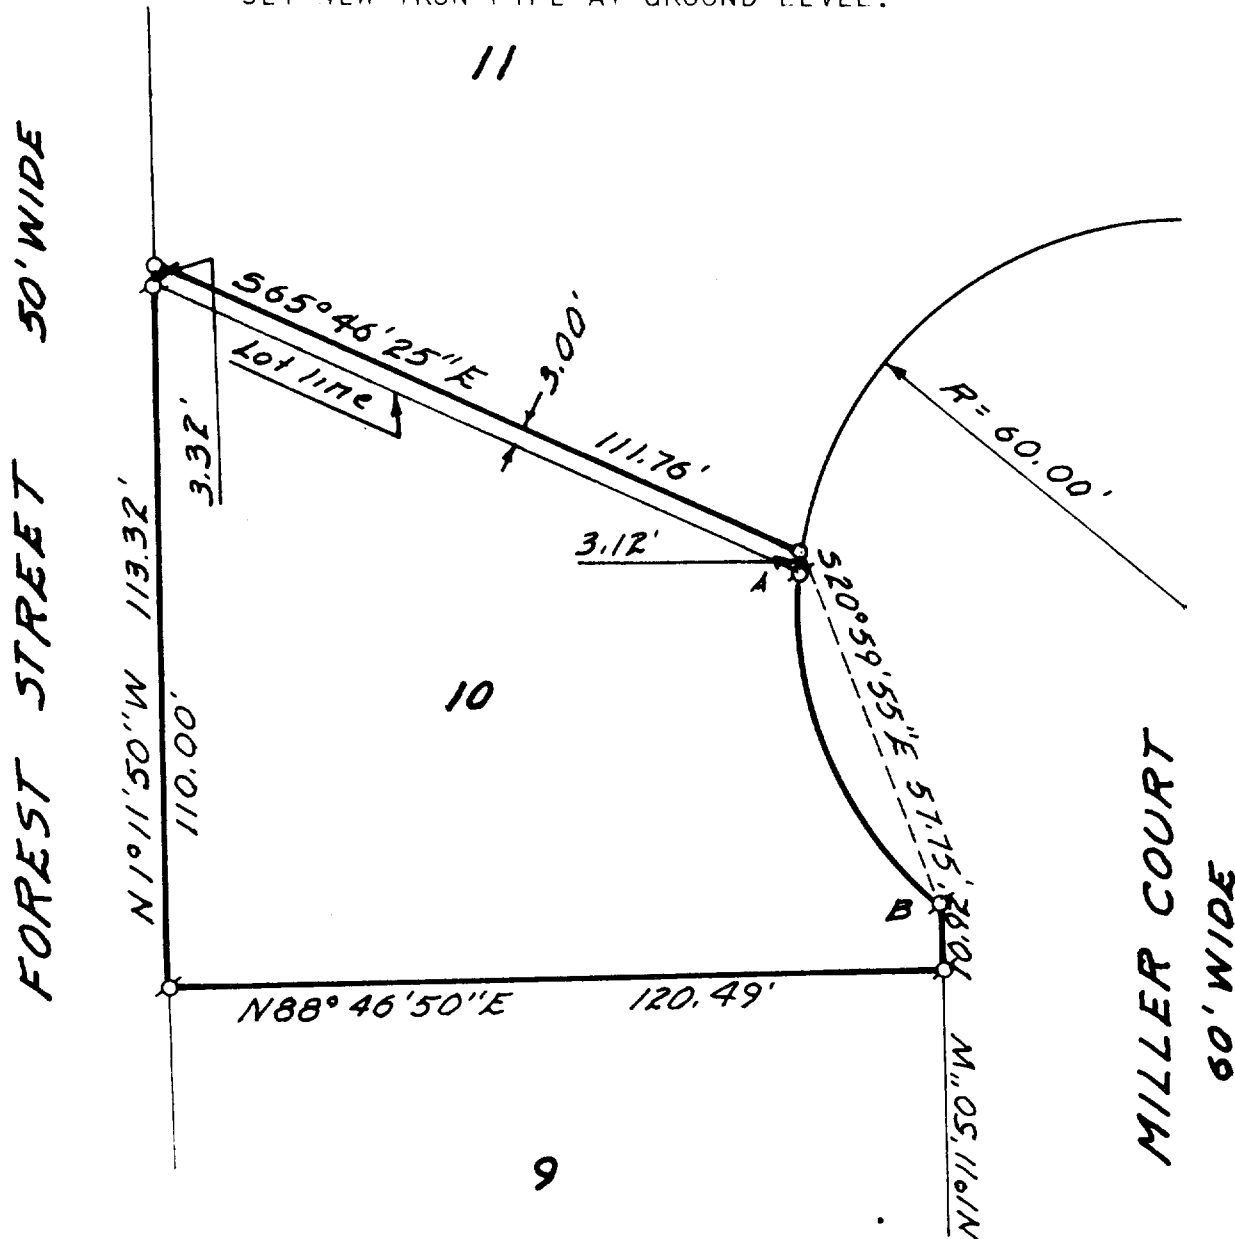

PLAT OF SURVEY OF

LOT 10 AND PART OF LOT 11, WESTGATE SUBDIVISION, LOCATED IN THE NORTHEAST ¼ OF SECTION 35, T 2 N, R 17 E, CITY OF LAKE GENEVA, WALWORTH COUNTY, WISCONSIN.

ORDERED BY: MEL MATTISON
438 W. MILLER COURT
LAKE GENEVA, WI. 53147

I, HAROLD H. KOLB, DO HEREBY CERTIFY THAT I HAVE SURVEYED THE PROPERTY HEREON DESCRIBED ACCORDING TO THE OFFICIAL RECORDS, AND THAT THE PLAT HEREON IS A CORRECT REPRESENTATION OF THE LOT LINES TO THE BEST OF MY KNOWLEDGE AND BELIEF.

Harold H. Kolb

WISCONSIN REGISTERED LAND SURVEYOR, S-
DATE NOVEMBER 9, 1982

SCALE: 1"=30'

LEGEND
IRON PIPE SET
IRON PIPE FOUND