


48-25

1.811

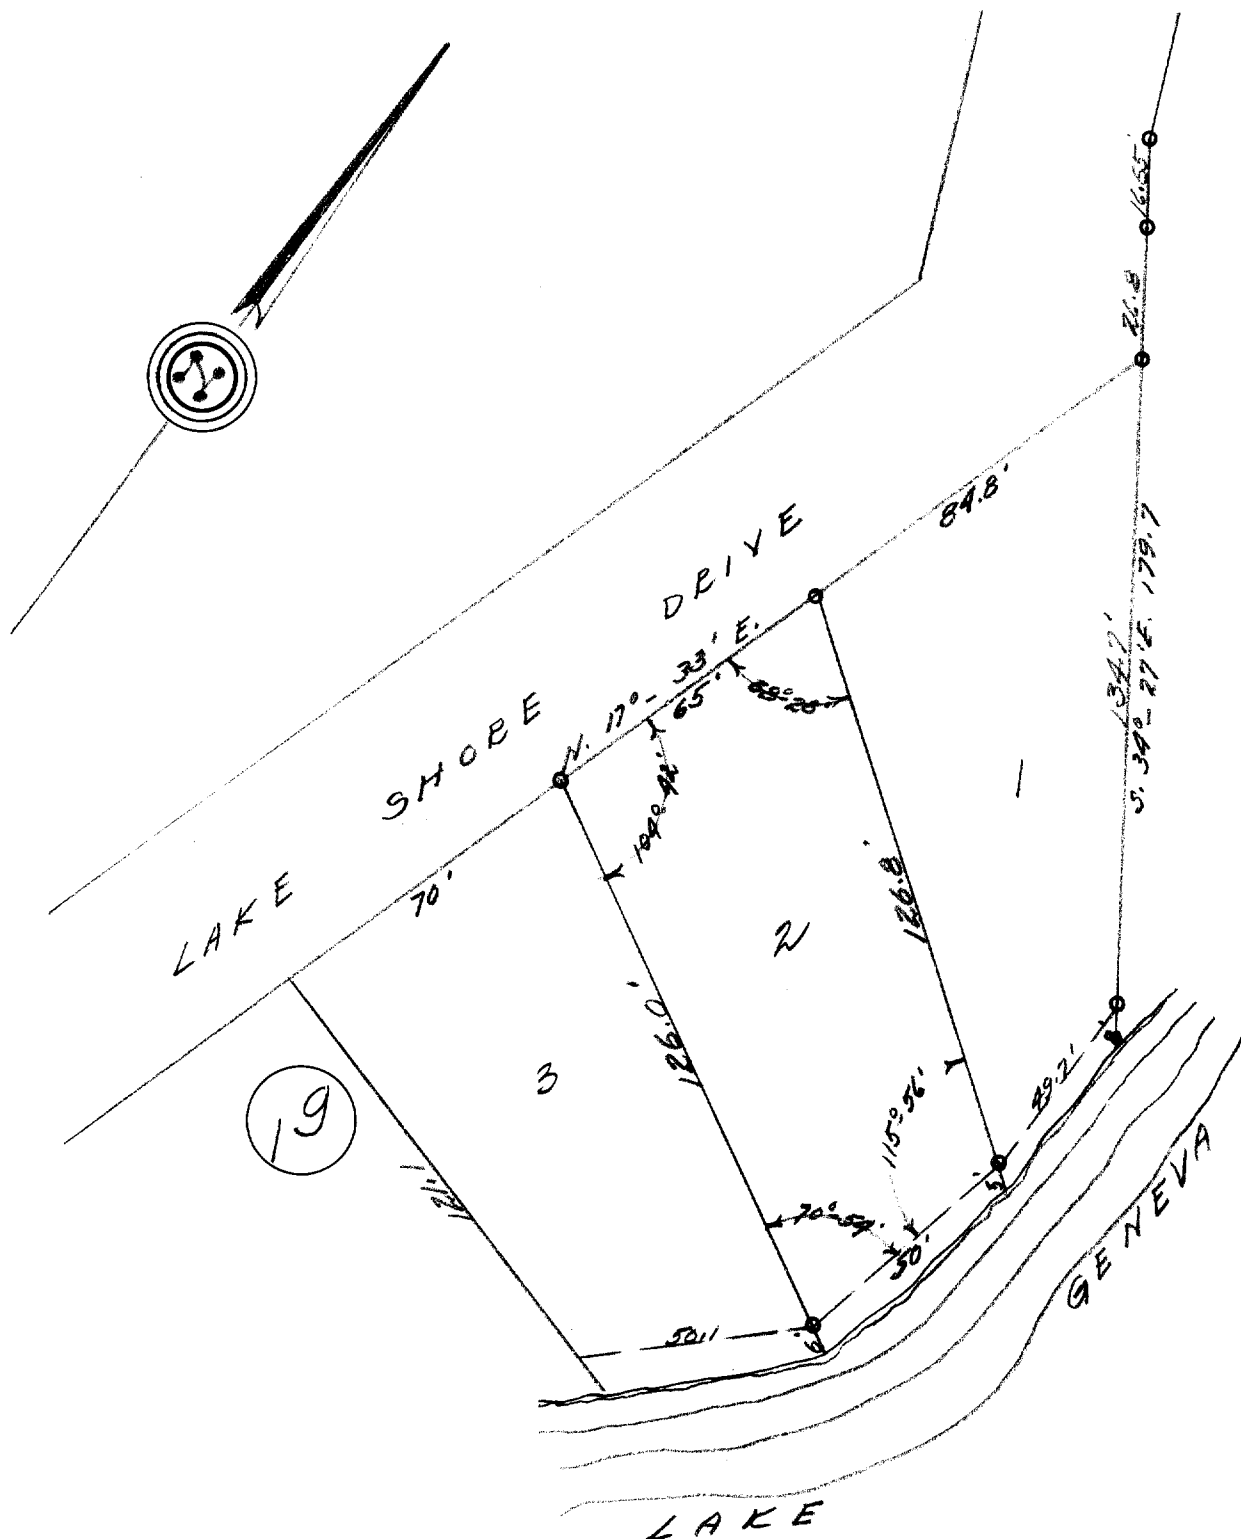

DESCRIPTION: Lot 2, Block 19, Lake Geneva Manor a subdivision of a portion of the City of Lake Geneva Walworth County, Wisconsin.

I, hereby certify that I, have on this the 8th day of October 1948. surveyed the above described property according to the official records on file in the office of the Recorder of Deeds in and for Walworth County, Wisconsin, and find that the measurements and bearings of the boundary lines of said property as taken at the site on this day substantially agree with those in the above description and that no encroachments exist.

SIGNED AND SEALED ON THIS THE 9TH DAY OF OCTOBER 1948,

*Joseph M. Biagi*  
Joseph M. Biagi, Professional Engineer.  
Elkhorn Wisconsin.