


KOLB LAND CONSULTING, INC.
LAND SURVEYING • SUBDIVIDING • LAND PLANNING

LAKE GENEVA, WISCONSIN 53147

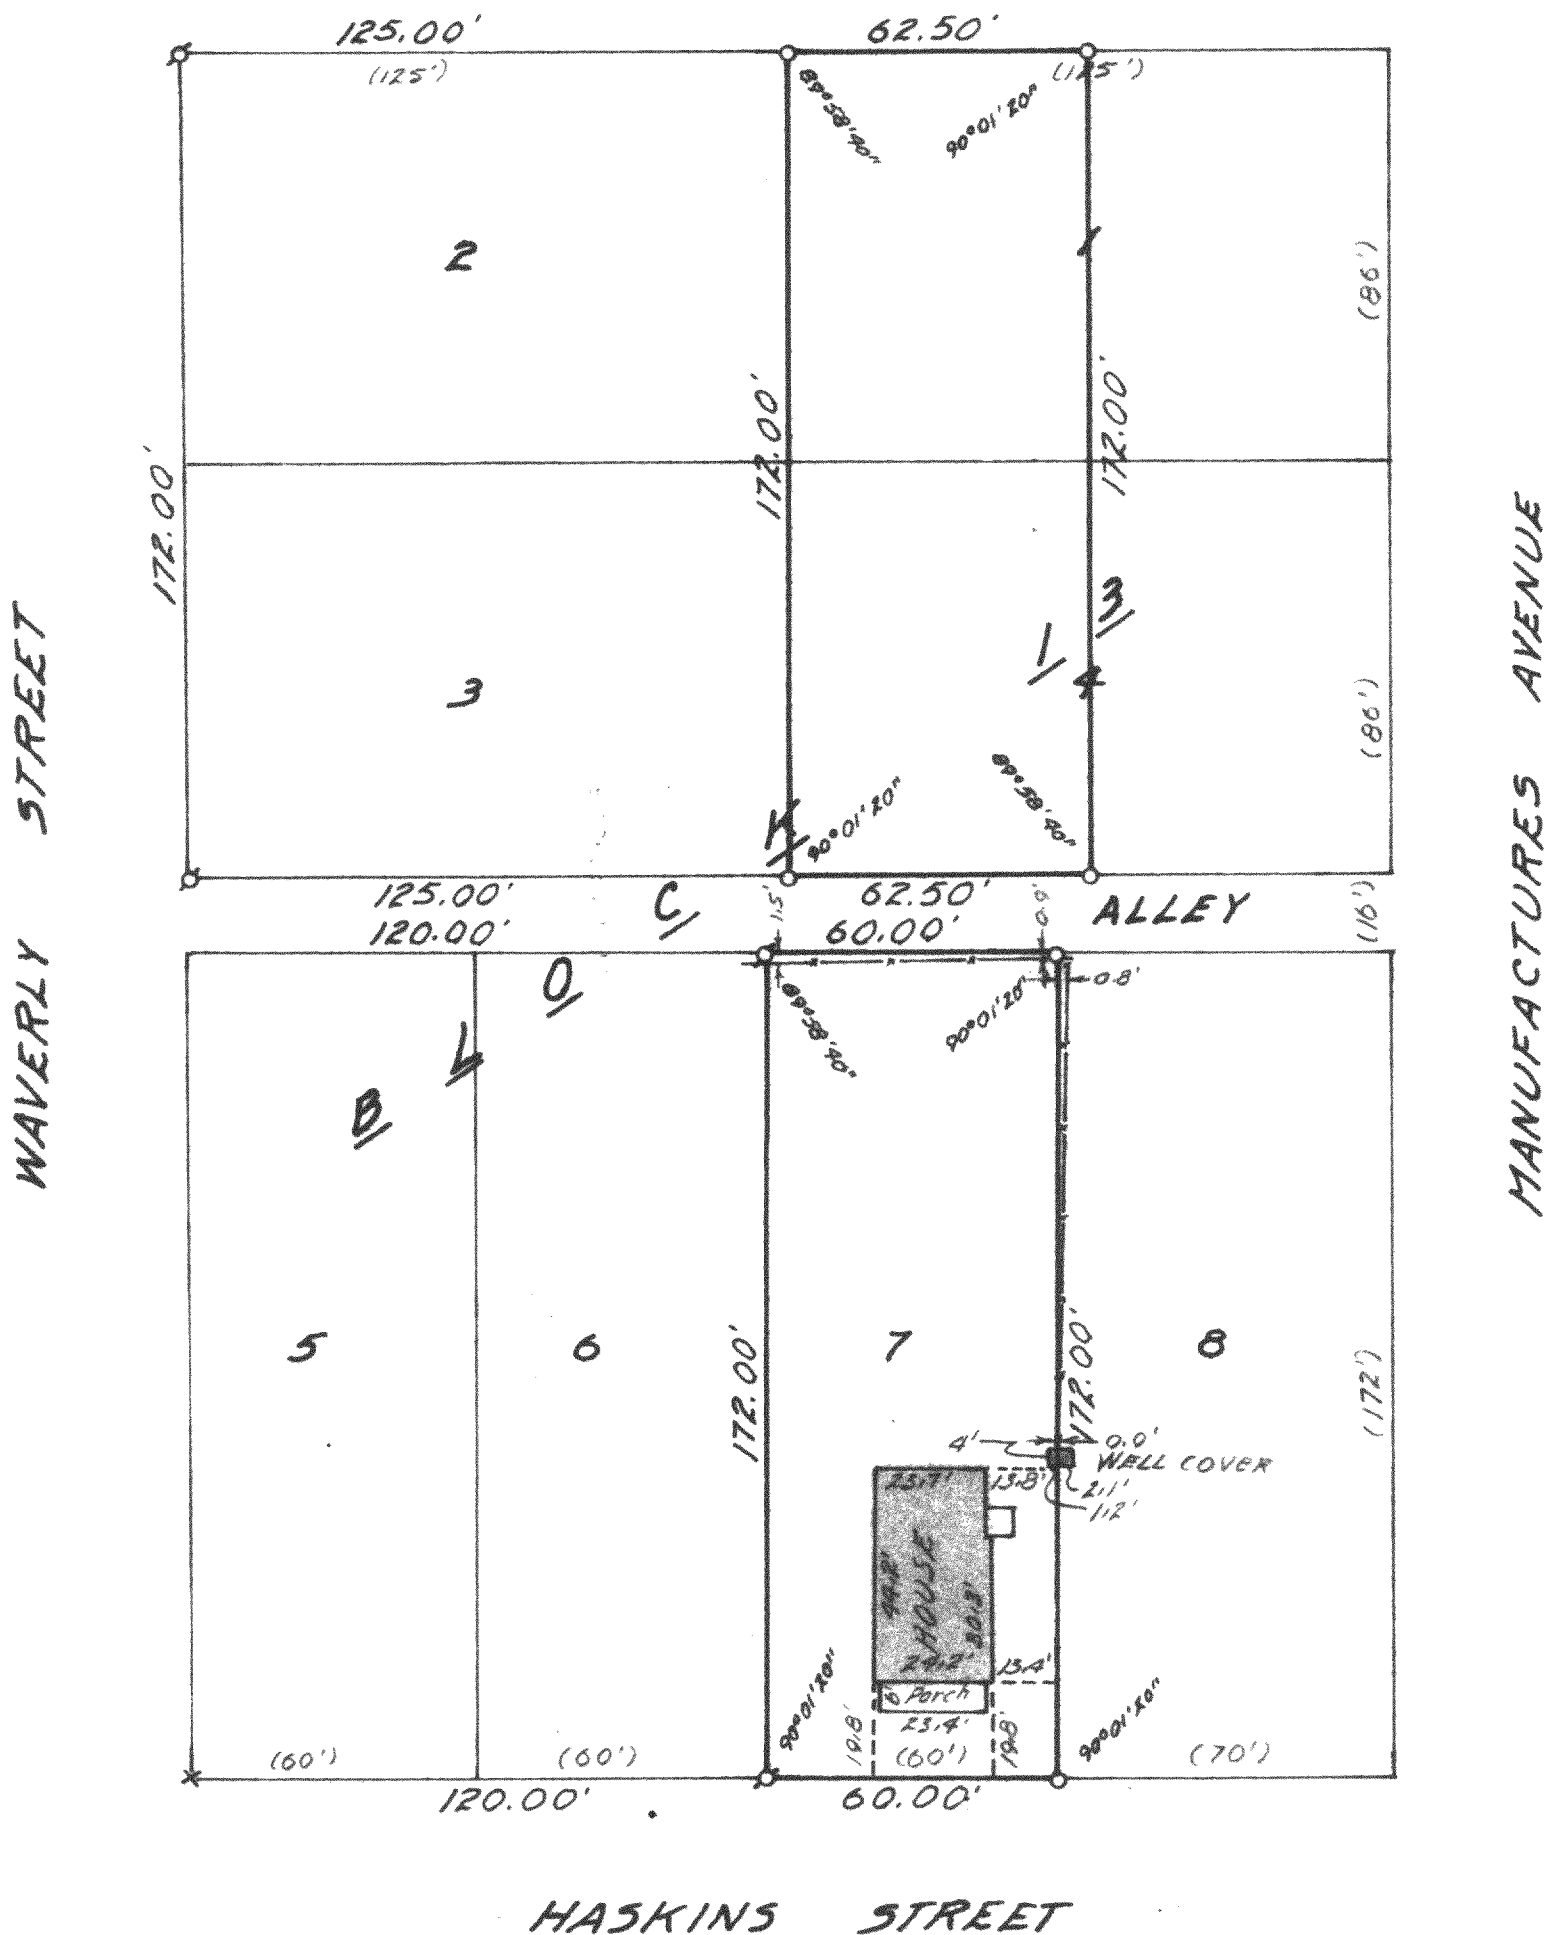

HASKINS STREET

PLAT OF SURVEY OF

LOT 7, BLOCK 13 AND THE WEST 1/2 OF LOTS 1 & 4, BLOCK 13,
GENEVA LAKE CRAWFORD MANUFACTURING COMPANY ADDITION TO THE
CITY OF LAKE GENEVA, WALWORTH COUNTY, WISCONSIN.

ORDERED BY: BETH TRUMAN

SCALE: 1"=40'

LEGEND
 ♂ IRON PIPE FOUND
 ○ IRON PIPE SET
 (60') RECORDED DISTANCE
 x SPIKE



I, HAROLD H. KOLB, DO HEREBY CERTIFY
THAT I HAVE SURVEYED THE PROPERTY
HEREON DESCRIBED ACCORDING TO THE
OFFICIAL RECORDS, AND THAT THE PLAT
HEREON IS A CORRECT REPRESENTATION
OF THE LOT LINES AND THE PRINCIPAL
LINES OF THE BUILDINGS THEREON TO THE
BEST OF MY KNOWLEDGE AND BELIEF.

Harold H. Kolb

WISCONSIN REGISTERED LAND SURVEYOR, S- 187
DATE DECEMBER 7, 1982