


53-3

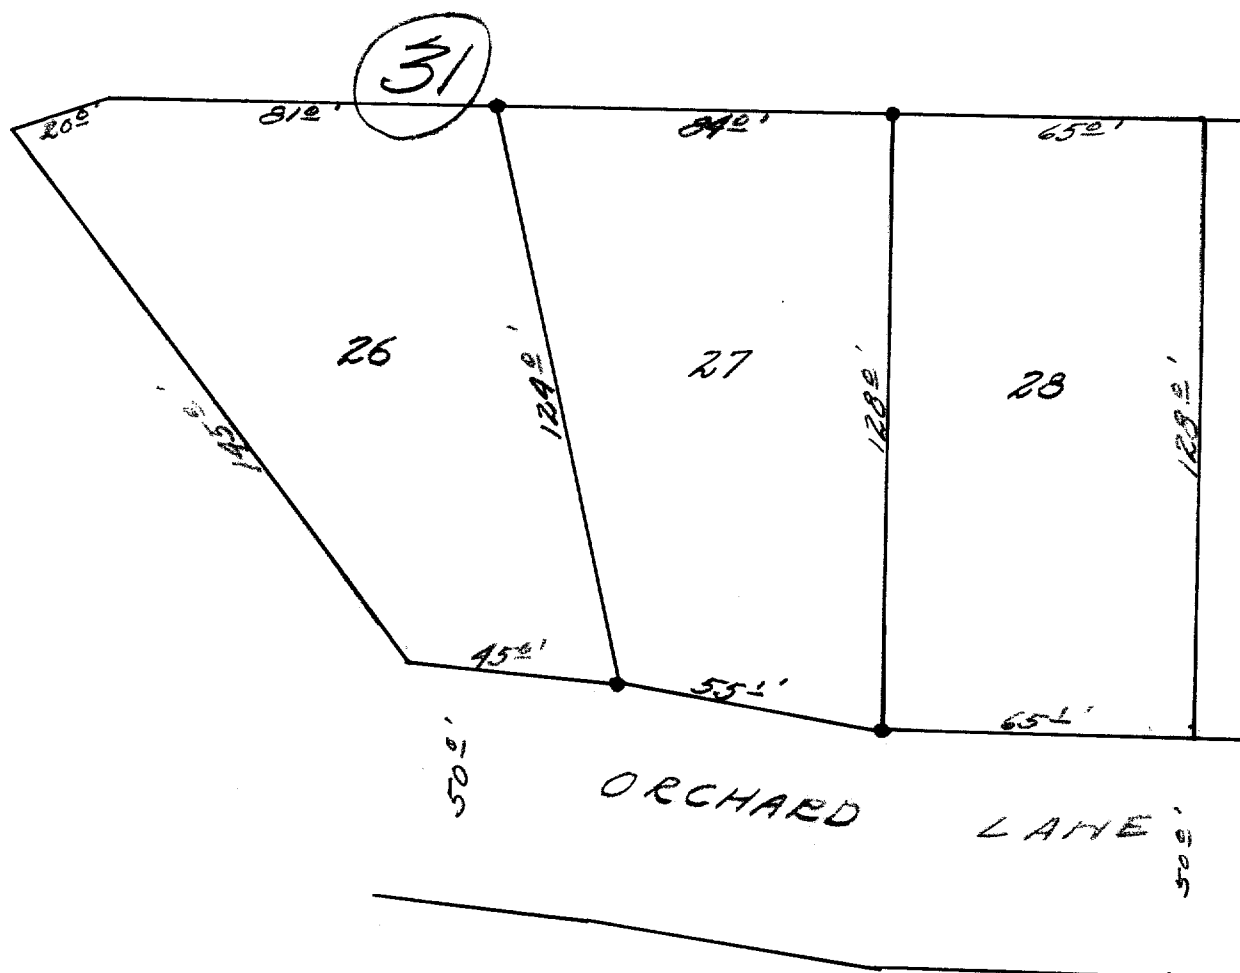

NORTH

DESCRIPTION: ~~XXXXXXXXXX~~ Lot 27 Block 31 Lake Geneva Manor a subdivision of a portion of the City of Lake Geneva Walworth County, Wisconsin.  
 CERTIFICATE: ~~XXXXXXXXXX~~ I, hereby certify that I have on this the 26th day of September 1953, surveyed the above described property, and find that no encroachments exist.  
 SIGNED AND SEALED THIS 28th DAY OF SEPTEMBER 1953.

*Joseph M. Biagi*  
 Joseph M. Biagi, Professional Engineer.  
 Elkhorn Wisconsin.

20M 04A

7-72B