


HAROLD H. KOLB

REGISTERED PROFESSIONAL LAND SURVEYOR

LAKE GENEVA, WISCONSIN

FOUND IRON PIPE 0.26' WEST OF CORNER

FOUND 2" CAPPED PIPE

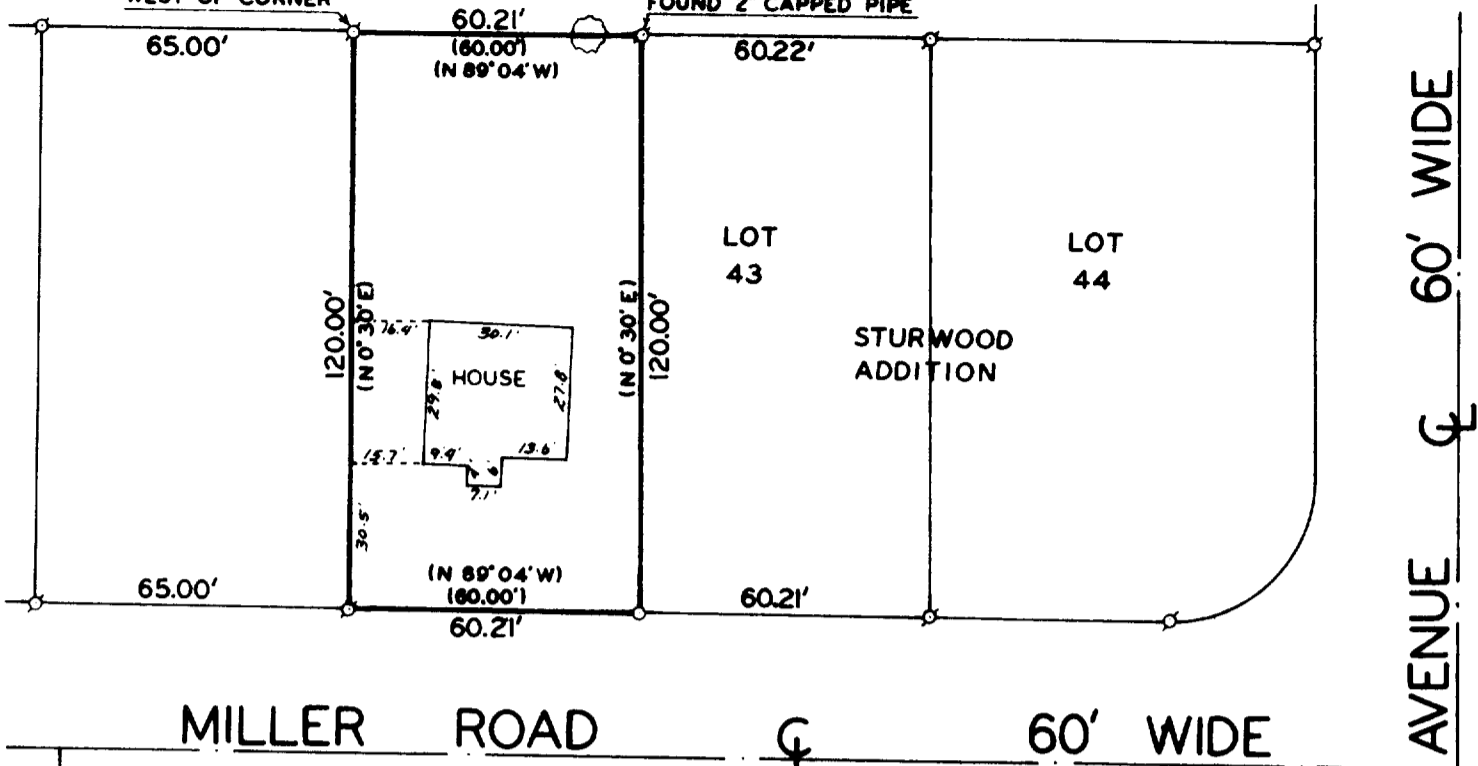

MILLER ROAD 60' WIDE

ELMWOOD AVENUE 60' WIDE

PLAT OF SURVEY OF

A PARCEL OF LAND LOCATED IN THE NE1/4 OF SECTION 35, T2N, R17E, CITY OF LAKE GENEVA, WALWORTH COUNTY, WISCONSIN, AS DESCRIBED IN VOLUME 157, PAGE 468, RECORDS.

ACCURACY: DISTANCES ± 0.01'
 ANGLES ± 05"

ERROR OF CLOSURE--LESS THAN ONE PART IN 3000

NOTE: PROPERTY LINE IS AS MARKED ON TREE BY PAINT LINE.

OWNER: ALICE ENGELMAN

MAY 22, 1984 - PROPERTY CORNERS RE-LOCATED AND HOUSE LOCATED.
 ORDERED BY: LAKE GENEVA REALTY



SCALE : 1" = 40'

LEGEND

- - IRON PIPE PLACED. 1" x 24" 1.13 LB./LIN. FT.
- - CONCRETE MONUMENT. 5" DIA. x 30"
- ⊕ - IRON PIPE FOUND () AS PLATTED

I, HAROLD H. KOLB, REGISTERED PROFESSIONAL LAND SURVEYOR, HAVE SURVEYED THE ABOVE PROPERTY AND HAVE FOUND THE CORNERS AS SHOWN ON THIS PLAT TO BE CORRECT. I HAVE BEEN ASSISTED BY THE FOLLOWING PERSONS: _____

 HAROLD H. KOLB
 WISCONSIN REGISTERED LAND SURVEYOR, S-187
 DATE April 18, 1977

REVISED: MAY 22, 1984

7-766^v