


HAROLD H. KOLB
 REGISTERED PROFESSIONAL LAND SURVEYOR
 LAKE GENEVA, WISCONSIN

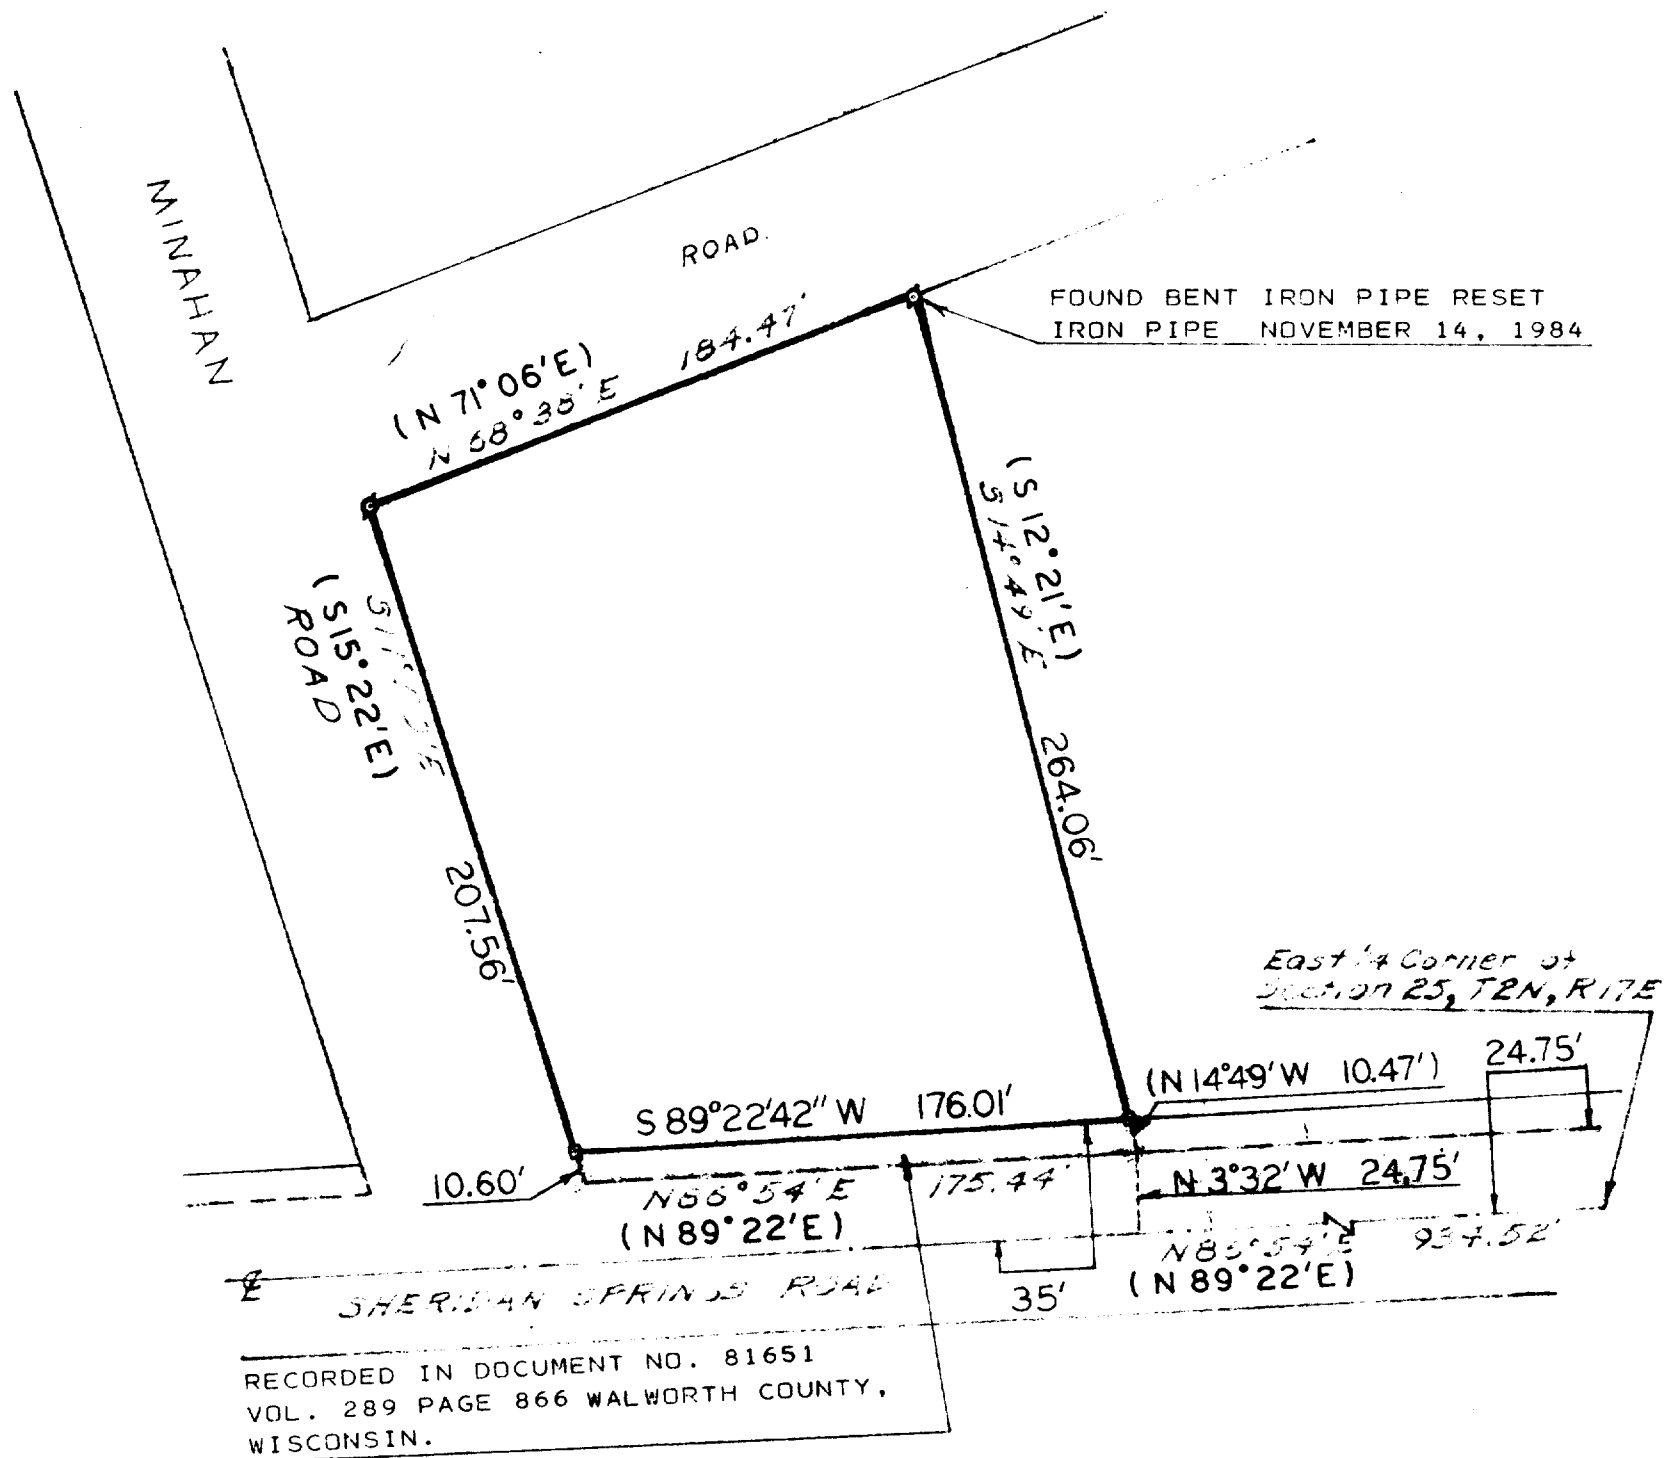


PLAT OF SURVEY OF
 A parcel of land located in the Northeast 1/4 of Section 25,
 T 2 N, R 17 E, City of Lake Geneva, Walworth County, Wis.

Revised on July 30, 1974--All iron pipe found and distances
 are within ± 0.10 foot.

NOTE: Bearings corrected and are based on the Wisconsin Plane
 Coordinate System as tied to U.S. Highway 12.

N
 SCALE 1" = 60'

LEGEND
 ♂ - IRON PIPE FOUND
 ○ - IRON PIPE PLACED
 ● - CONCRETE MONUMENT
 x - SPIKE
 () - RECORDED AS
 □ - IRON ROD FOUND

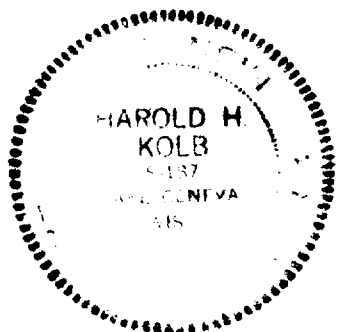

I, HAROLD H. KOLB, DO HEREBY CERTIFY THAT I HAVE
 SURVEYED THE PROPERTY HEREON DESCRIBED ACCORDING
 TO THE OFFICIAL RECORDS, AND THAT THE PLAT HEREON
 IS A CORRECT REPRESENTATION OF THE LOT LINES.

Harold H. Kolb
 HAROLD H. KOLB
 WISCONSIN REGISTERED LAND SURVEYOR, S-187
 DATE June 8, 1967
 Revised: July 30, 1974
 REVISED: NOVEMBER 14, 1984

4UP-137-B

7-772-K