

SEP 30 1985


929 WILLIAMS STREET

LAKE GENEVA, WISCONSIN 53147

414-248-3697

FOUND IRON ROD-BENT
3ET IRON PIPE

CONANT STREET

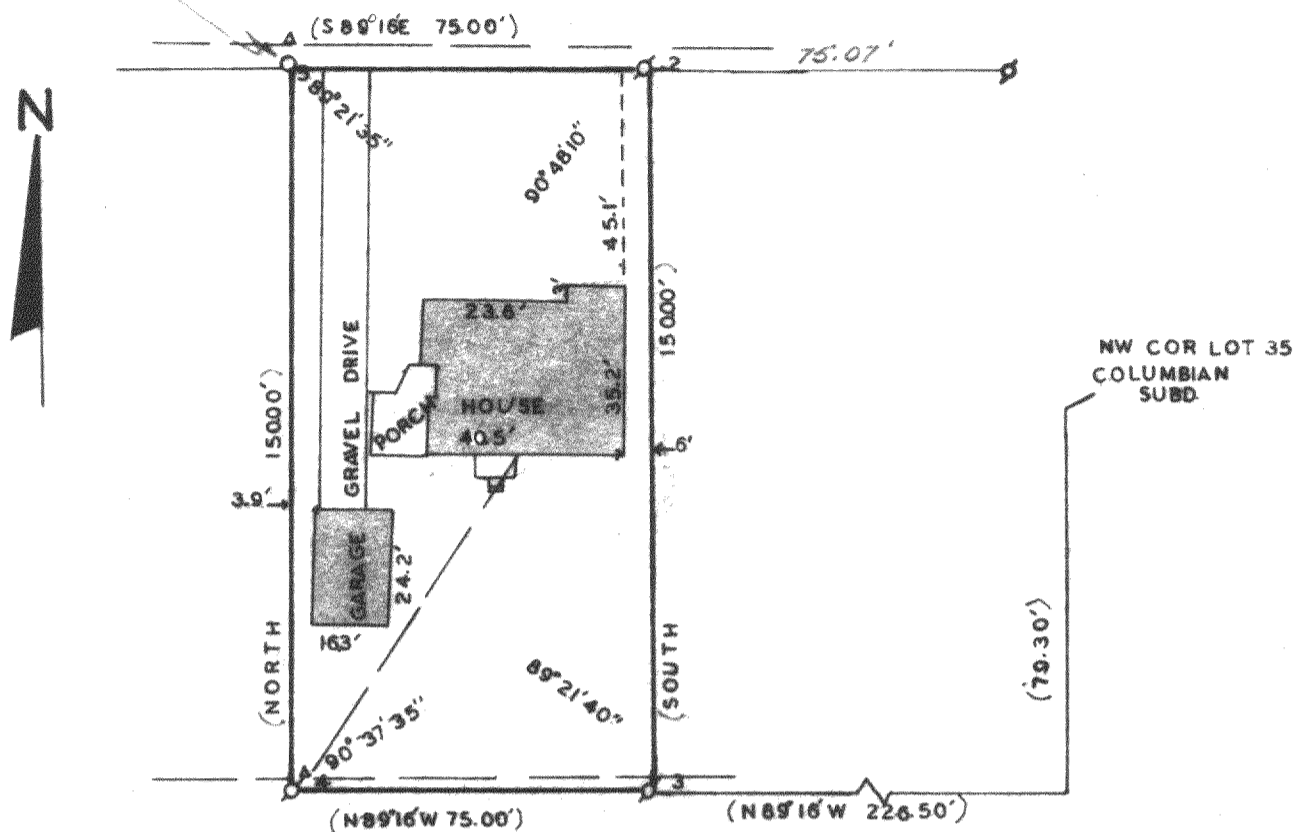

A PARCEL OF LAND LOCATED IN THE EAST 1/2 OF THE
SOUTHEAST 1/4 OF SECTION 26, T2N, R17E, CITY OF
LAKE GENEVA, WALWORTH COUNTY WISCONSIN, AS DESCRIBED
IN VOLUME 594 OF DEEDS, PAGE 633, WALWORTH COUNTY
RECORDS.

OWNER:
OLAF TAMMARK
1490 CONANT ST.
LAKE GENEVA, WI. 53147

I HEREBY CERTIFY THAT I HAVE SURVEYED THE ABOVE DESCRIBED PROPERTY AND THAT THE ABOVE MAP IS A TRUE REPRESENTATION THEREOF AND SHOWS THE SIZE AND LOCATION OF THE PROPERTY, ITS EXTERIOR BOUNDRIES, THE LOCATION OF ALL VISIBLE STRUCTURES AND DIMENSIONS OF ALL PRINCIPAL BUILDINGS THEREON, BOUNDARY FENCES, APPARENT EASEMENTS, ROADWAYS AND VISIBLE ENCROACHMENTS, IF ANY, TO THE BEST OF MY KNOWLEDGE AND BELIEF.

THIS SURVEY IS MADE FOR THE USE OF THE PRESENT OWNERS OF THE PROPERTY, AND ALSO THOSE WHO PURCHASE, MORTGAGE, OR GUARANTEE THE TITLE THERETO WITHIN ONE (1) YEAR FROM THE DATE HEREOF.



SCALE: 1" = 40'

Ø IRON PIPE FOUND
 Δ UTILITY POLE
 — — OVERHEAD UTILITY LINES
 (100') AS RECORDED
 O 1" X 24" IRON PIPE
 SET

Harold H. Kolb
HAROLD H. KOLB

WISCONSIN REGISTERED LAND SURVEYOR, S- 187

DATE MAY 15, 1985

REVISÉ

REVISÉ

ZYUP-00048-D

7-780-K