


# PLAT OF SURVEY

PARCELS OF LAND LOCATED IN THE NORTHEAST 1/4 OF  
SECTION 26, T2N., R17E, CITY OF LAKE GENEVA, WALWORTH  
COUNTY, WISCONSIN.

ABERNATHY & ASSOCIATES  
RT. 3 BOX 273  
ELKHORN, WI 53121  
(414) 723-4280

SURVEYED FOR - DEAN NOBLE  
BOX 1385 ELKHORN RD.  
LAKE GENEVA, WI. 53147

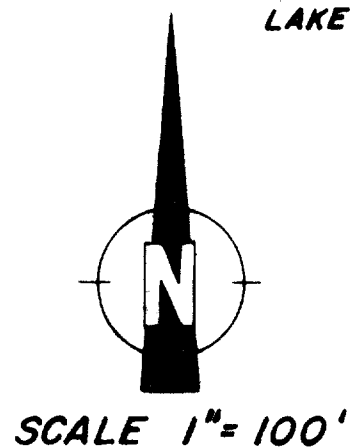

## LEGEND

- Ø - IRON PIPE FOUND
  - ( ) - RECORD DIMENSION
  - - WALWORTH COUNTY SECTION CORNER
- BEARINGS ARE BASED ON WISCONSIN STATE PLANE COORDINATE  
SYSTEM, SOUTH ZONE

## SURVEYOR'S CERTIFICATE:

I, Kenneth B. Abernathy Jr., do hereby certify that I have surveyed the above described property  
and that this plat of survey is a true and accurate representation of the boundary lines and  
buildings thereon to the best of my professional knowledge and belief.




MAY 2, 1985

*Kenneth B. Abernathy Jr.*  
Kenneth B. Abernathy Jr.  
Wis. Reg. Surveyor No. S-1594

## NORTHEAST CORNER SECTION 26-2-17

State Plane Coordinates  
North: 226,766.48  
East: 2,419,207.64

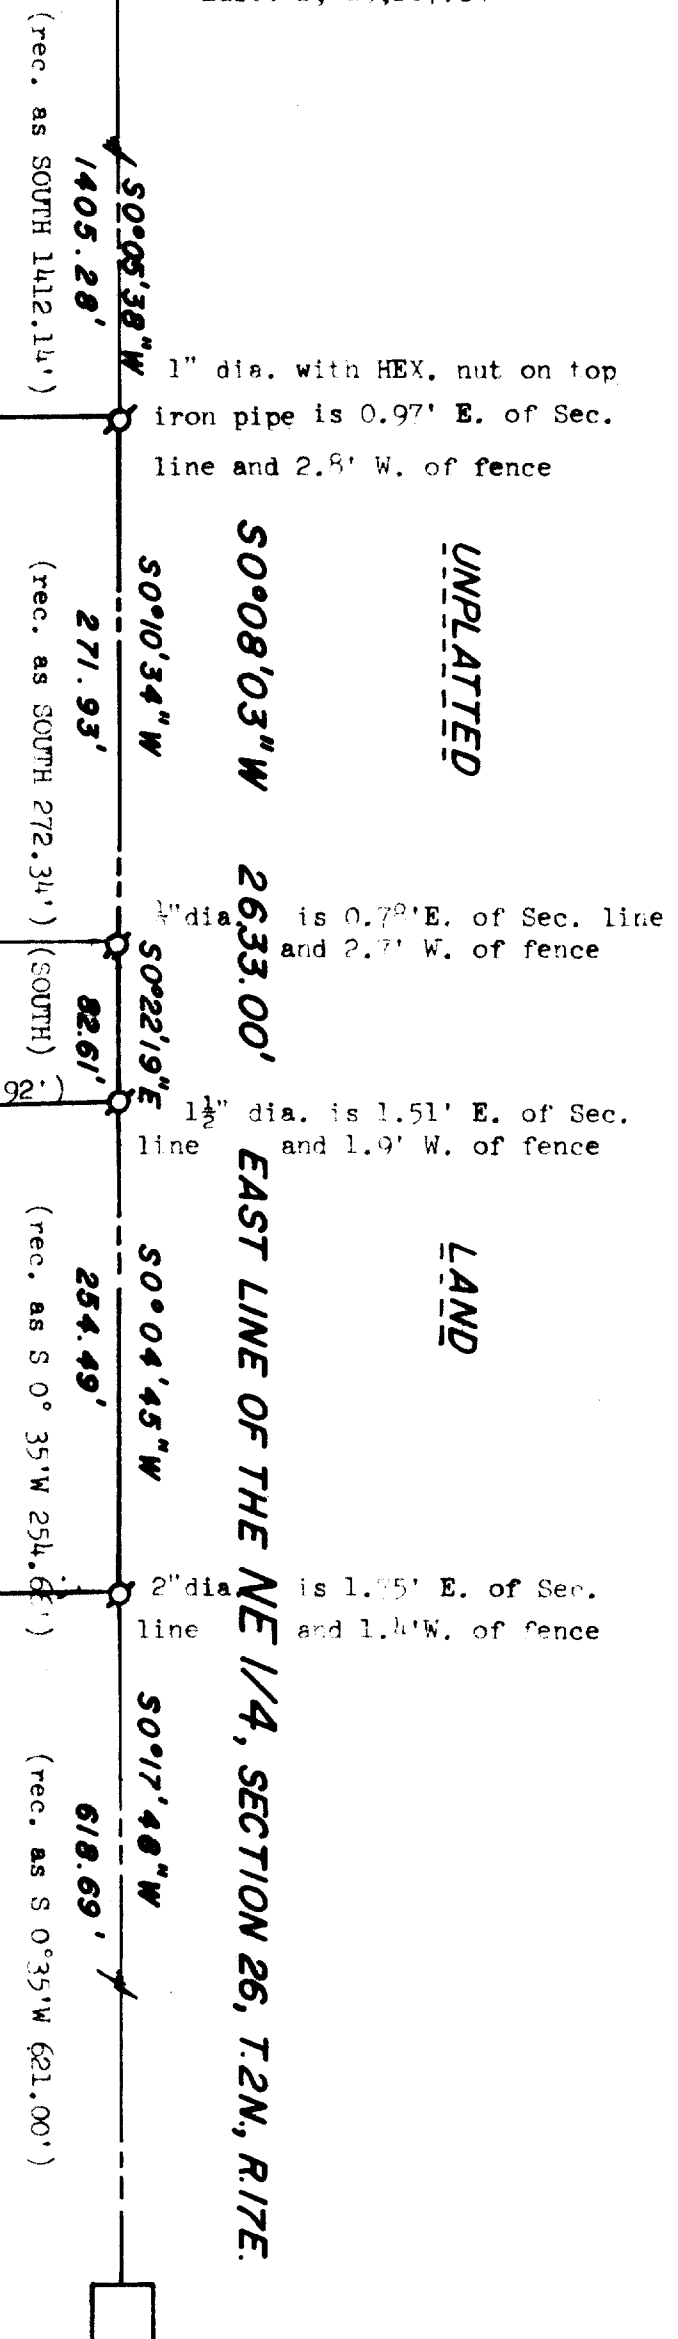

## EAST 1/4 CORNER SECTION 26-2-17

State Plane Coordinates  
North: 224,133.49  
East: 2,419,201.47

4 up - 408  
all - 408  
# 930

NO. 1985.201

7-781