


RECEIVED
JUL 1985
R. L.

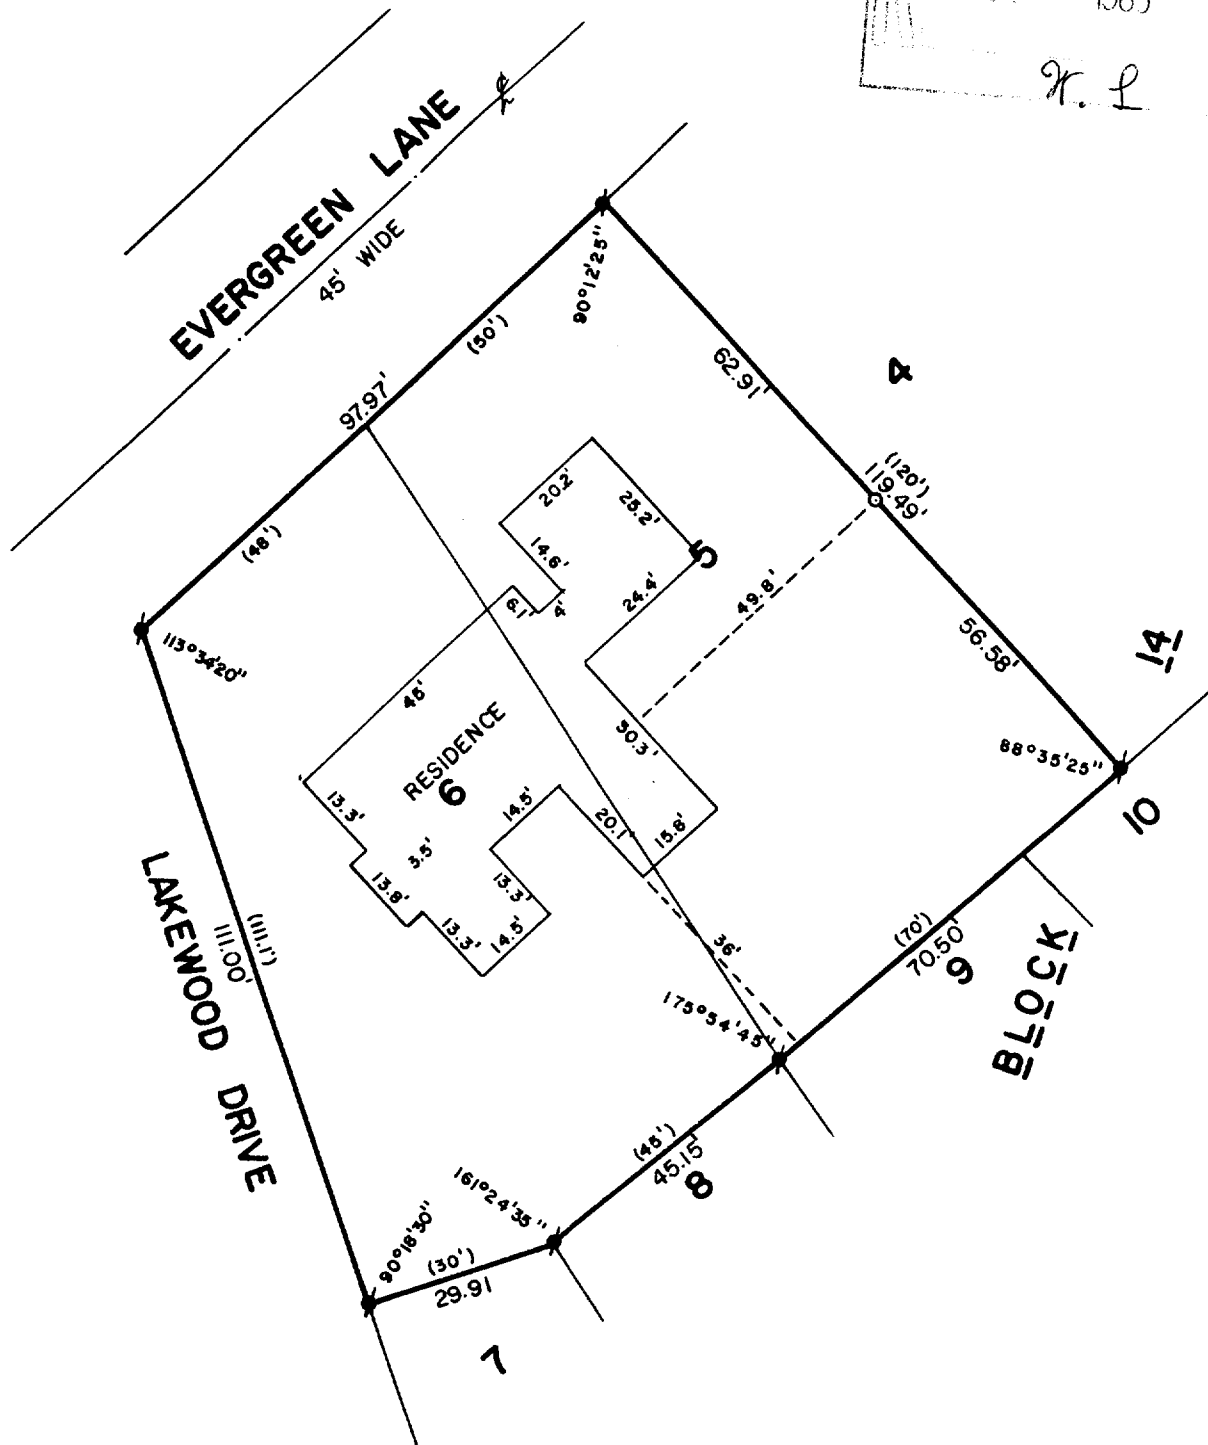

LOTS 5 AND 6, BLOCK 14, LAKE GENEVA MANOR,
A SUBDIVISION LOCATED IN THE CITY OF LAKE
GENEVA, WALWORTH COUNTY, WISCONSIN.

WISCONSIN
STATE BAR ASSOCIATION
JULY 1927
JULY 1927



○ - IRON PIPE PLACED
 ■ - CONCRETE MONUMENT FOUND
 () - RECORDED AS

Robert M. Baerenwald
ROBERT M. BAERENWALD
WISCONSIN REGISTERED LAND SURVEYOR, S-1508

DATE May 18, 1984

JOB NO. 0056

ZLM-17

7-789v