

POINT DESCRIBED AS 32 RODS 16' NORTH
OF THE NORTHEAST CORNER OF LOT 1 OF
RICHES ADDITION

WALWORTH COUNTY
SURVEYING & MAPPING
LAKE GENEVA, WISCONSIN

PLAT OF SURVEY OF

A PARCEL OF LAND LOCATED IN THE SOUTHWEST 1/4 OF
SECTION 25, T 2 N, R 17 E, CITY OF LAKE GENEVA,
WALWORTH COUNTY, WISCONSIN AND DESCRIBED AS FOLLOWS:
BEGINNING AT A POINT ON THE CENTERLINE OF WILLIAMS
STREET 32 RODS 16 FEET NORTH OF THE NORTHEAST CORNER
OF LOT 1 OF RICHES ADDITION, THENCE WEST 330.00 FEET;
THENCE SOUTH 60.00 FEET; THENCE EAST 330.00 FEET;
THENCE NORTH 60.00 FEET TO THE PLACE OF BEGINNING.


ORDERED BY: COLDWELL BANKER-GENEVA LAKES AREA
REALTORS
838 MAIN STREET
LAKE GENEVA, WISCONSIN 53147

I HEREBY CERTIFY THAT I HAVE SURVEYED THE ABOVE DESCRIBED
PROPERTY AND THAT THE ABOVE MAP IS A TRUE REPRESENTATION
THEREOF AND SHOWS THE SIZE AND LOCATION OF THE PROPERTY,
ITS EXTERIOR BOUNDARIES, THE LOCATION OF ALL VISIBLE
STRUCTURES AND DIMENSIONS OF ALL PRINCIPAL BUILDINGS THEREON,
BOUNDARY FENCES, APPARENT EASEMENTS, ROADWAYS AND VISIBLE
ENCROACHMENTS, IF ANY.


THIS SURVEY IS MADE FOR THE USE OF THE PRESENT OWNERS OF THE
PROPERTY, AND ALSO THOSE WHO PURCHASE, MORTGAGE, OR GUARANTEE
THE TITLE THERETO WITHIN ONE (1) YEAR FROM DATE HEREOF.

Robert M. Baerenwald
ROBERT M. BAERENWALD
WISCONSIN REGISTERED LAND SURVEYOR, S-1508

DATE *JUNE 27, 1984*
JOB NO. 0078

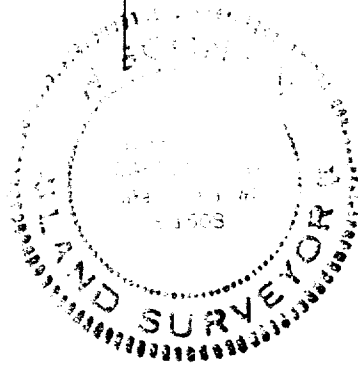

SCALE: 1"=30'
σ - IRON PIPE FOUND
○ - IRON PIPE PLACED
() - RECORDED AS

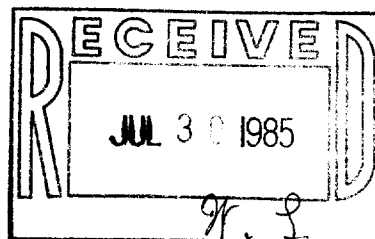

1401 02

7-795