


RECEIVED
OCT 22 1985

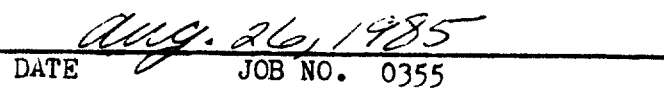

W T 50

7-808-2