

## WALWORTH COUNTY SURVEYING & MAPPING LAKE GENEVA, WISCONSIN

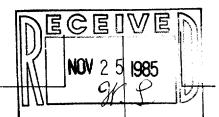

## RUSH STREET

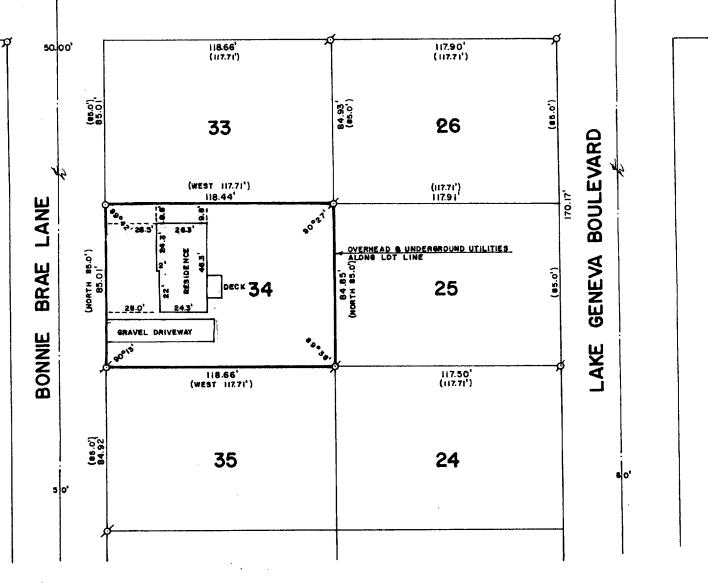

## PLAT OF SURVEY OF


LOT 34 OF H. E. WELLS ADDITION TO THE CITY OF LAKE GENEVA, WALWORTH COUNTY, WISCONSIN.

ORDERED BY:

JOHN LAW REALTORS

803 MAIN STREET

LAKE GENEVA, WISCONSIN 53147

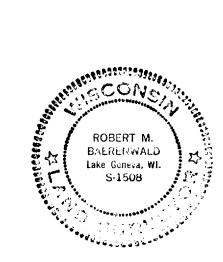



SCALE: 1"=50'

ø-IRON PIPE FOUND o-IRON ROD SET ()-RECORDED AS

ROW PTPR ROUNT

I HEREBY CERTIFY THAT I HAVE SURVEYED THE ABOVE
DESCRIBED PROPERTY AND THAT THE ABOVE MAP IS A TRUE
REPRESENTATION THEREOF AND SHOWS THE SIZE AND LOCATION
OF THE PROPERTY, ITS EXTERIOR BOUNDARIES, THE LOCATION
OF ALL VISIBLE STRUCTURES AND DIMENSIONS OF ALL PRINCIPAL
BUILDINGS THEREON, BOUNDARY FENCES, APPARENT EASEMENTS,
ROADWAYS AND VISIBLE ENCROACHMENTS, IF ANY.

THIS SURVEY IS MADE FOR THE USE OF THE PRESENT OWNERS OF THE PROPERTY AND ALSO THOSE WHO PURCHASE, MORTGAGE OR GUARANTEE THE TITLE THERETO WITHIN ONE (1) YEAR FROM DATE HEREOF.

ROBERT M. BAERENWALD

WISCONSIN REGISTERED LAND SURVEYOR, S-1508

J. A. 30 1985

JOB NO. 0412

7-809

Zw = 49