


WALWORTH COUNTY SURVEYING & MAPPING LAKE GENEVA, WISCONSIN

EUGENE DRIVE

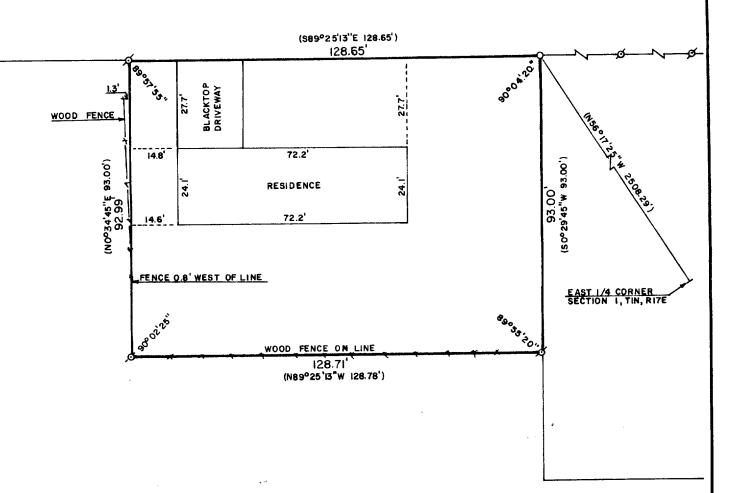

PLAT OF SURVEY OF

A PARCEL OF LAND LOCATED IN THE NORTHEAST 1/4 OF SECTION 1, T 1 N, R 17 E, CITY OF LAKE GENEVA, WALWORTH COUNTY, WISCONSIN, DESCRIBED AS FOLLOWS: COMMENCING AT THE EAST 1/4 CORNER OF SAID SECTION 1, THENCE N56°17'25"W 2508.29 FEET TO THE PLACE OF BEGINNING; THENCE SO°29'45"W 93.00 FEET; THENCE N89°25'13"W 128.78 FEET; THENCE N0°34'45"E 93.00 FEET; THENCE S89°25'13"E 128.65 FEET TO THE PLACE OF BEGINNING.



ORDERED BY: KENOSHA SAVINGS & LOAN

410 BROAD STREET

LAKE GENEVA, WISCONSIN 53147



SCALE: 1"=30"

ø -IRON PIPE FOUND

O - IRON ROD SET

()-RECORDED AS

11-1

I, ROBERT M. BAERENWALD, DO HEREBY CERTIFY THAT I HAVE SURVEYED THE PROPERTY HEREON DESCRIBED ACCORDING TO THE OFFICIAL RECORDS AND THAT THE PLAT HEREON IS A CORRECT REPRESENTATION OF THE PROPERTY LINES TO THE BEST OF MY KNOWLEDGE AND BELIEF.

ROBERT M. BAERENWALD
WISCONSIN REGISTERED LAND SURVEYOR, S-1508

DATE JOB NO. 0450

7-818