


WALWORTH COUNTY  
SURVEYING & MAPPING  
LAKE GENEVA, WISCONSIN


EUGENE DRIVE

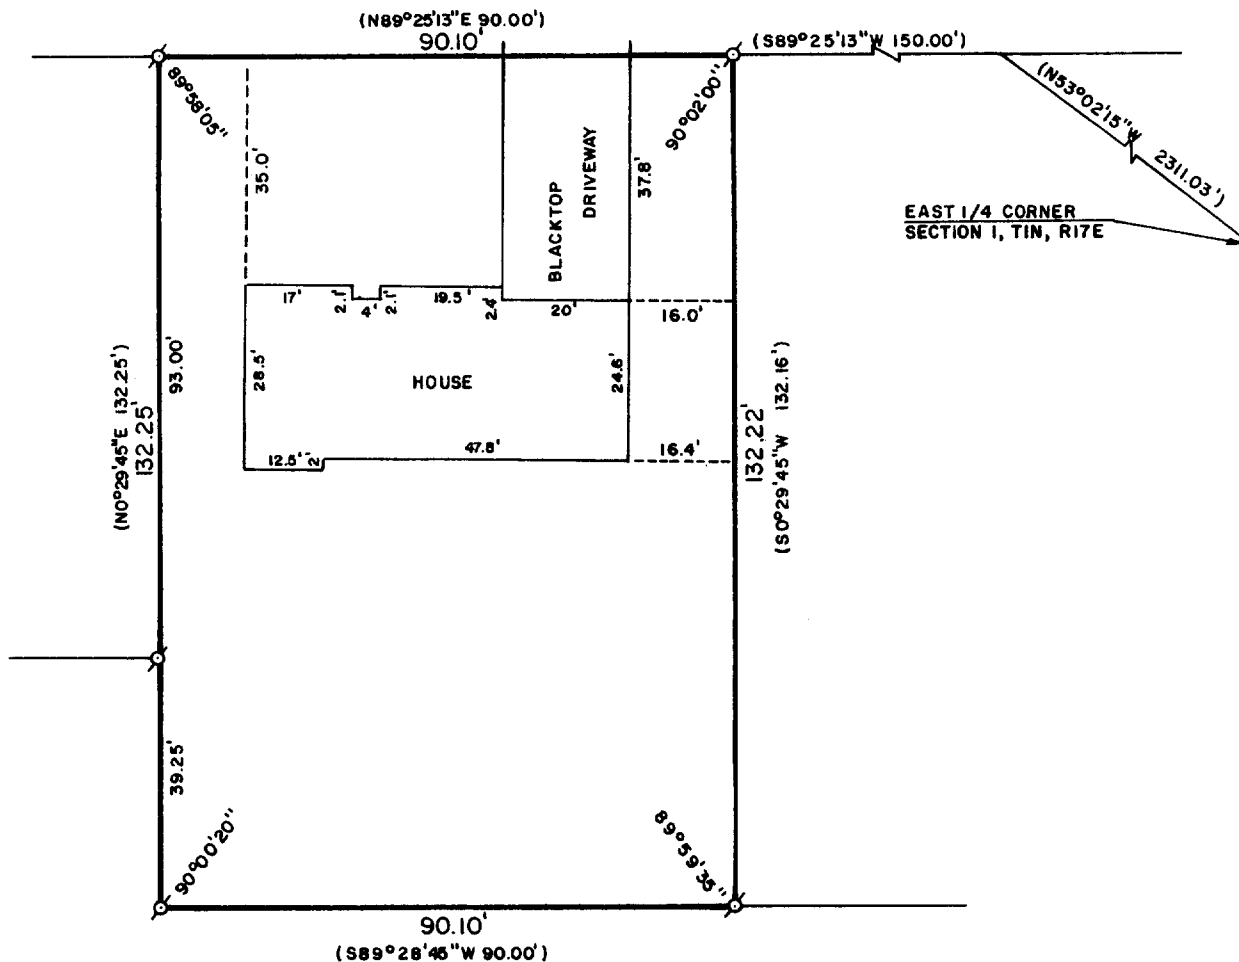

PLAT OF SURVEY OF

A PARCEL OF LAND LOCATED IN THE NORTHEAST 1/4 OF SECTION 1, T 1 N, R 17 E,  
CITY OF LAKE GENEVA, WALWORTH COUNTY, WISCONSIN, DESCRIBED AS FOLLOWS:  
COMMENCING AT THE EAST 1/4 CORNER OF SAID SECTION 1, THENCE N53°02'15"W  
2311.03 FEET; THENCE S89°25'13"W 150.00 FEET TO THE PLACE OF BEGINNING;  
THENCE S0°29'45"W 132.16 FEET; THENCE S89°28'45"W 90.00 FEET; THENCE  
N0°29'45"E 132.25 FEET; THENCE N89°25'13"E 90.00 FEET TO THE PLACE OF  
BEGINNING.

ORDERED BY: STURGE TAGGART AGENCY  
736 MAIN STREET  
LAKE GENEVA, WISCONSIN 53147

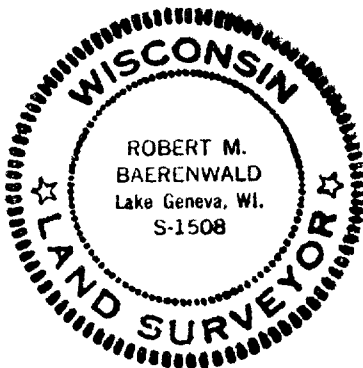

NOTE: THERE ARE NO ENCROACHMENTS.



SCALE: 1"=30'

⊗ - IRON PIPE FOUND  
( ) - RECORDED AS

I, ROBERT M. BAERENWALD, DO HEREBY CERTIFY THAT I  
HAVE SURVEYED THE PROPERTY HEREON DESCRIBED ACCORDING  
TO THE OFFICIAL RECORDS AND THAT THE PLAT HEREON IS A  
CORRECT REPRESENTATION OF THE PROPERTY LINES TO THE  
BEST OF MY KNOWLEDGE AND BELIEF.

*Robert M. Baerenwald*  
ROBERT M. BAERENWALD  
WISCONSIN REGISTERED LAND SURVEYOR, S-1508

DATE *May 6, 1986* JOB NO. 0544

YUP-121-K

7-827