
## DUNHAM & RASMUSSEN SURVEYING & ENGINEERING DELAVAN, WISCONSIN

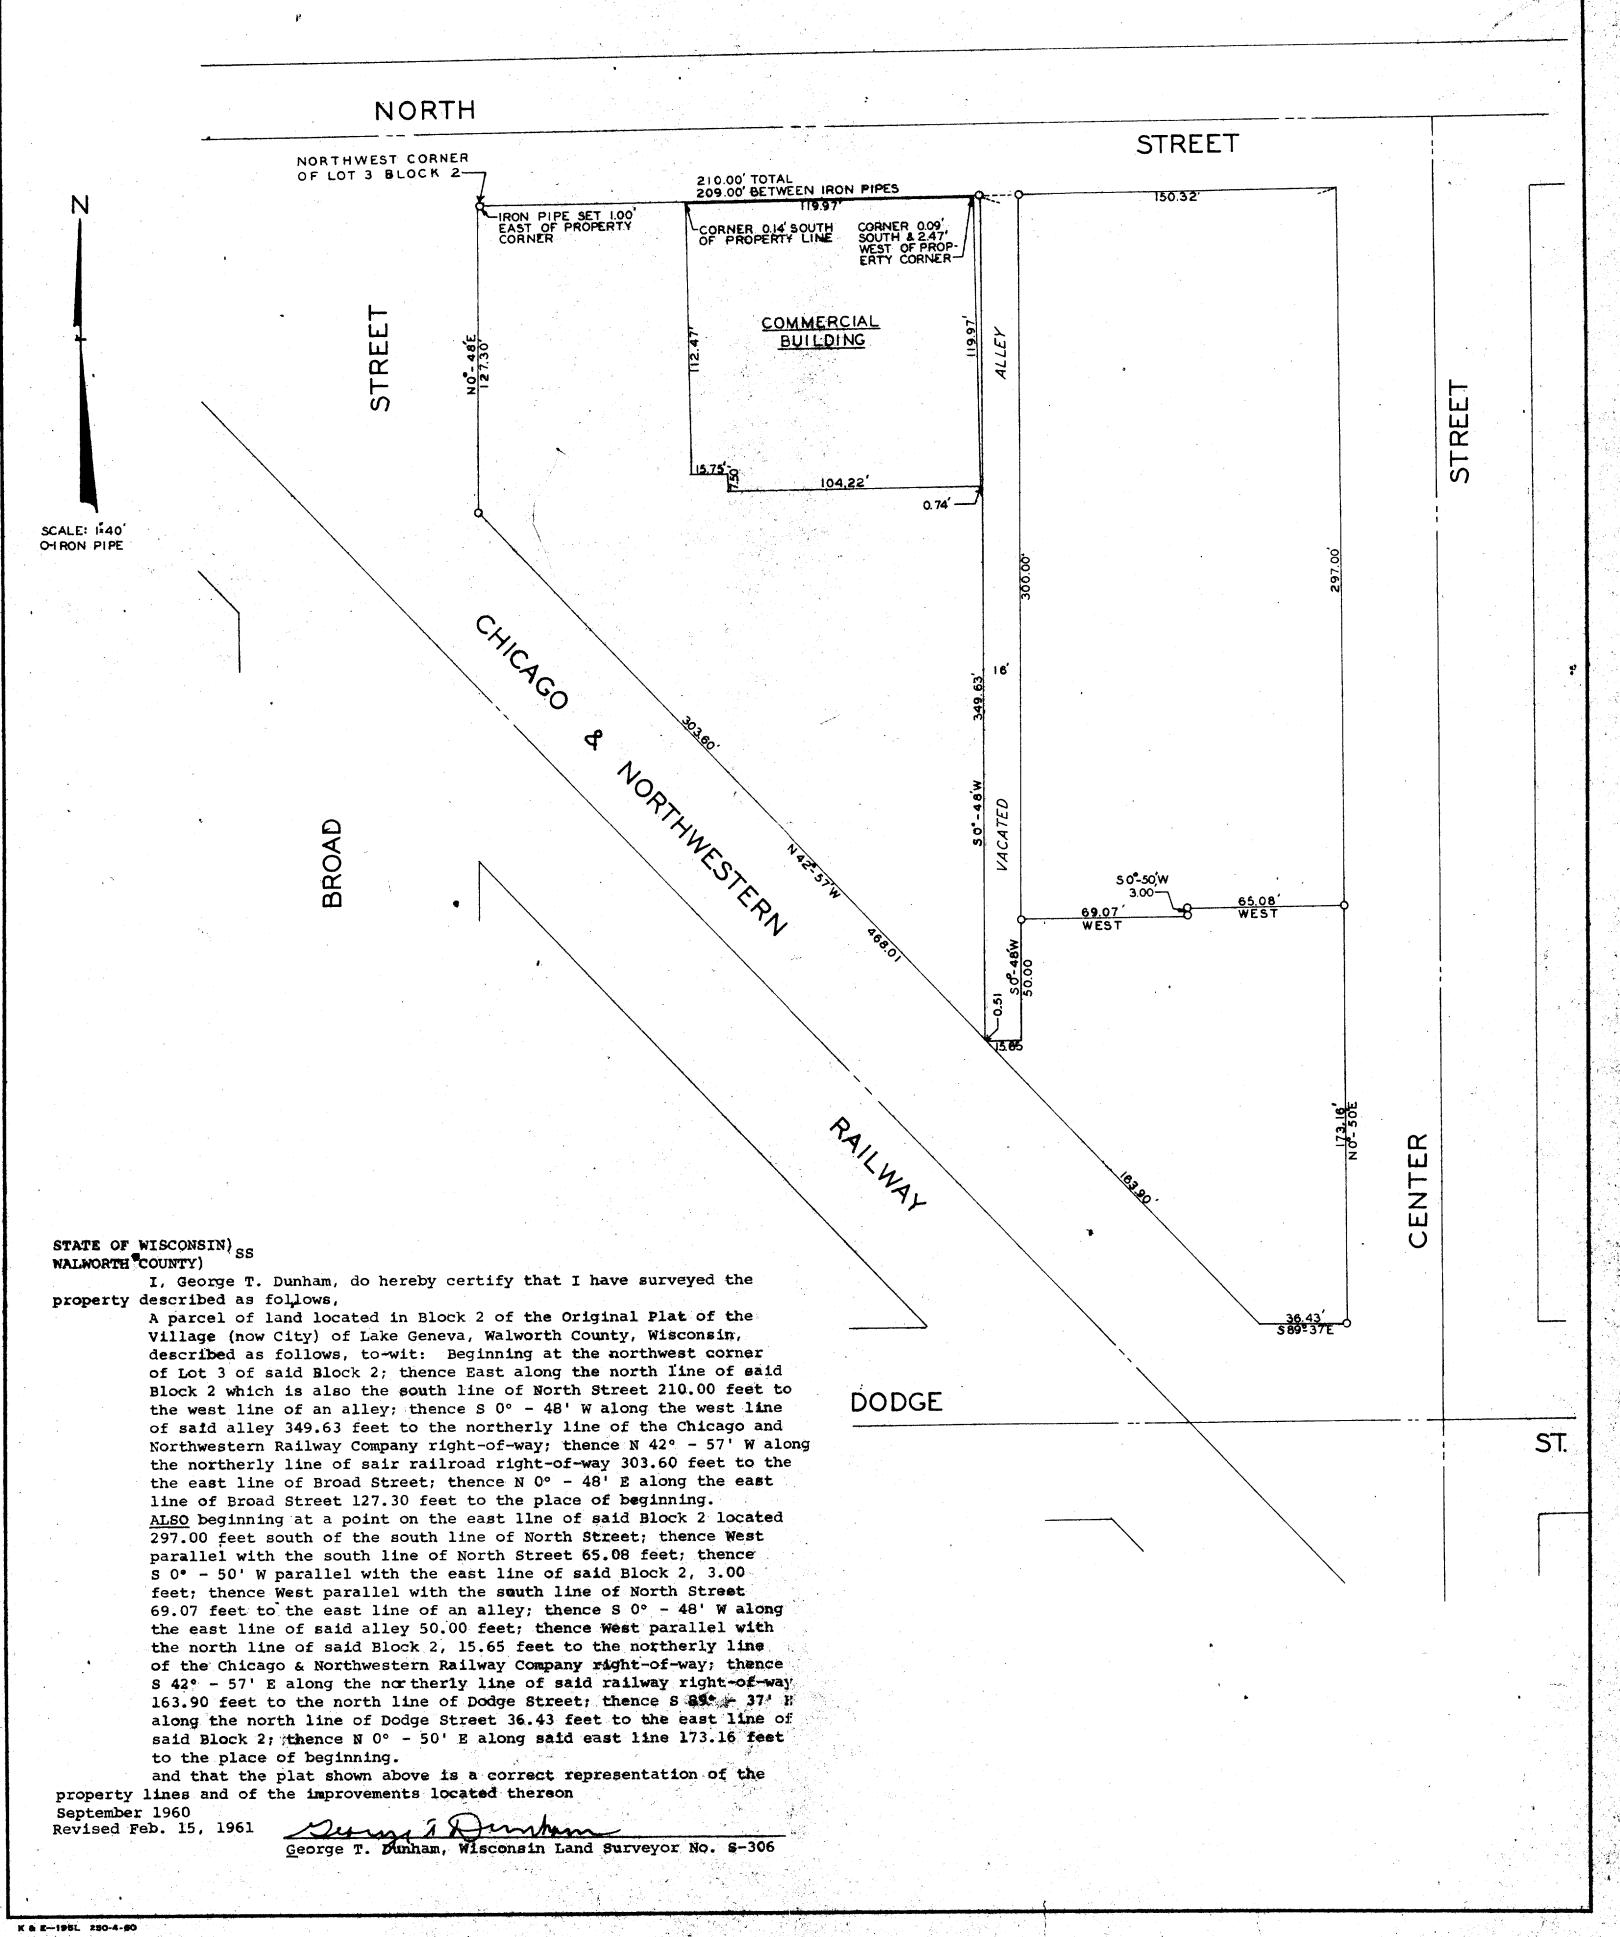

0P-23 thu 0P-28