


KOLB LAND CONSULTING, INC.
 LAND SURVEYING · SUBDIVIDING · LAND PLANNING

929 WILLIAMS STREET LAKE GENEVA, WISCONSIN 53147 414-248-3697

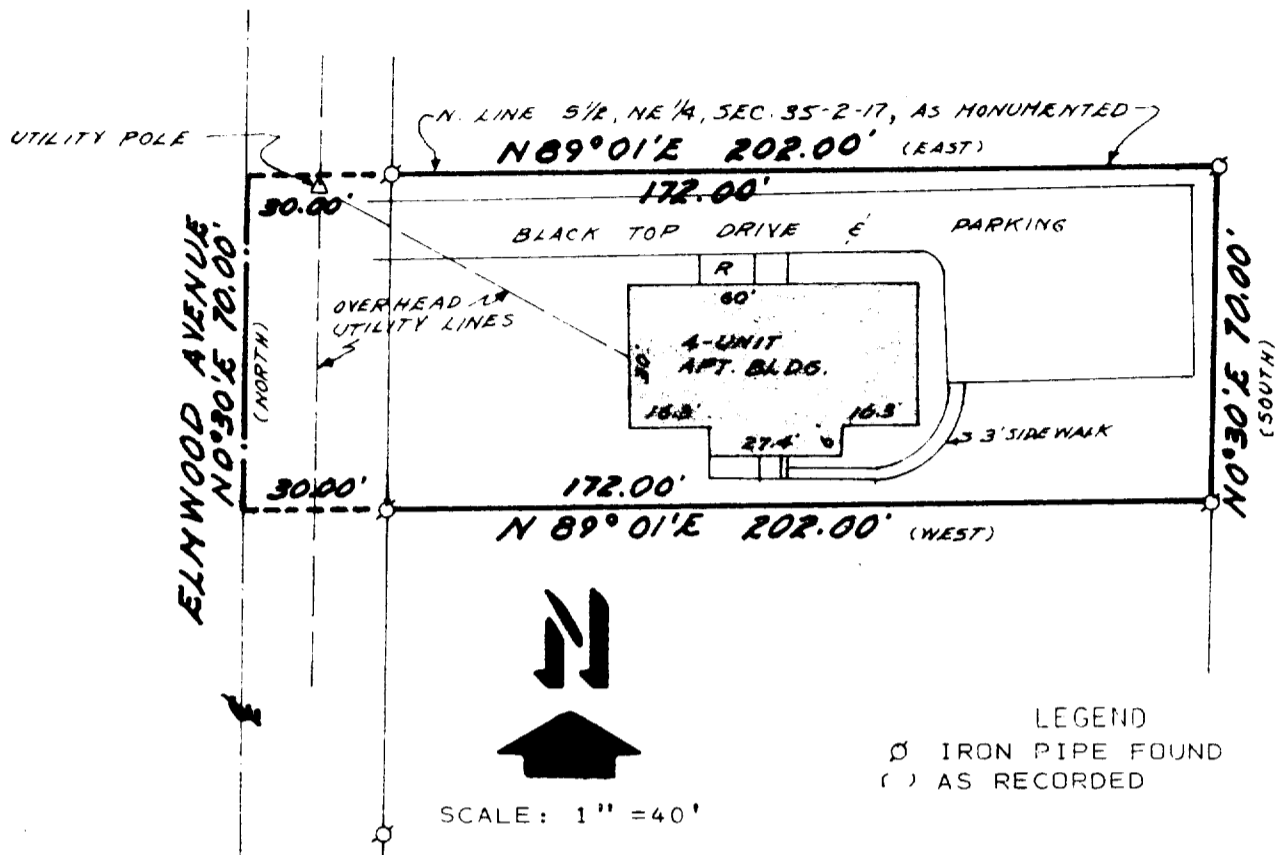


PLAT OF SURVEY OF

A PARCEL OF LAND LOCATED IN THE SOUTHEAST 1/4 OF THE
 NORTHEAST 1/4 OF SECTION 35, T 2 N, R 17 E, CITY OF LAKE
 GENEVA, WALWORTH COUNTY, WISCONSIN.

OWNER: WILLIAM LOEHRER
 APT. 1807A HENLY ST.
 GLENVIEW, IL. 60025

NOTE: BEARINGS ARE ASSUMED
 AS SHOWN ON EXISTING
 SURVEY RECORDS.

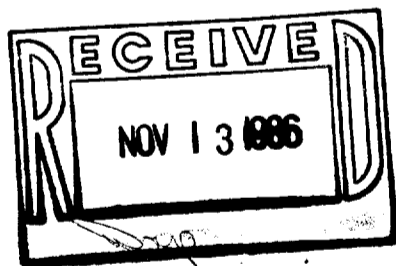

I HEREBY CERTIFY THAT I HAVE SURVEYED THE
 ABOVE DESCRIBED PROPERTY AND THAT THE ABOVE
 MAP IS A TRUE REPRESENTATION THEREOF AND
 SHOWS THE SIZE AND LOCATION OF THE PROPERTY,
 ITS EXTERIOR BOUNDARIES, THE LOCATION OF ALL
 VISIBLE STRUCTURES AND DIMENSIONS OF ALL
 PRINCIPAL BUILDINGS THEREON, BOUNDARY FENCES,
 APPARENT EASEMENTS, ROADWAYS AND VISIBLE
 ENCROACHMENTS, IF ANY, TO THE BEST OF MY
 KNOWLEDGE AND BELIEF.

THIS SURVEY IS MADE FOR THE USE OF THE
 PRESENT OWNERS OF THE PROPERTY AND ALSO THOSE
 WHO PURCHASE, MORTGAGE, OR GUARANTEE THE
 TITLE THERETO WITHIN ONE (1) YEAR FROM DATE
 HEREOF.

Harold H. Kolb

HAROLD H. KOLB
 WISCONSIN REGISTERED LAND SURVEYOR, S-187

DATE OCTOBER 6, 1986

REVISED

REVISED