


57-16 (3)

57-88B-1

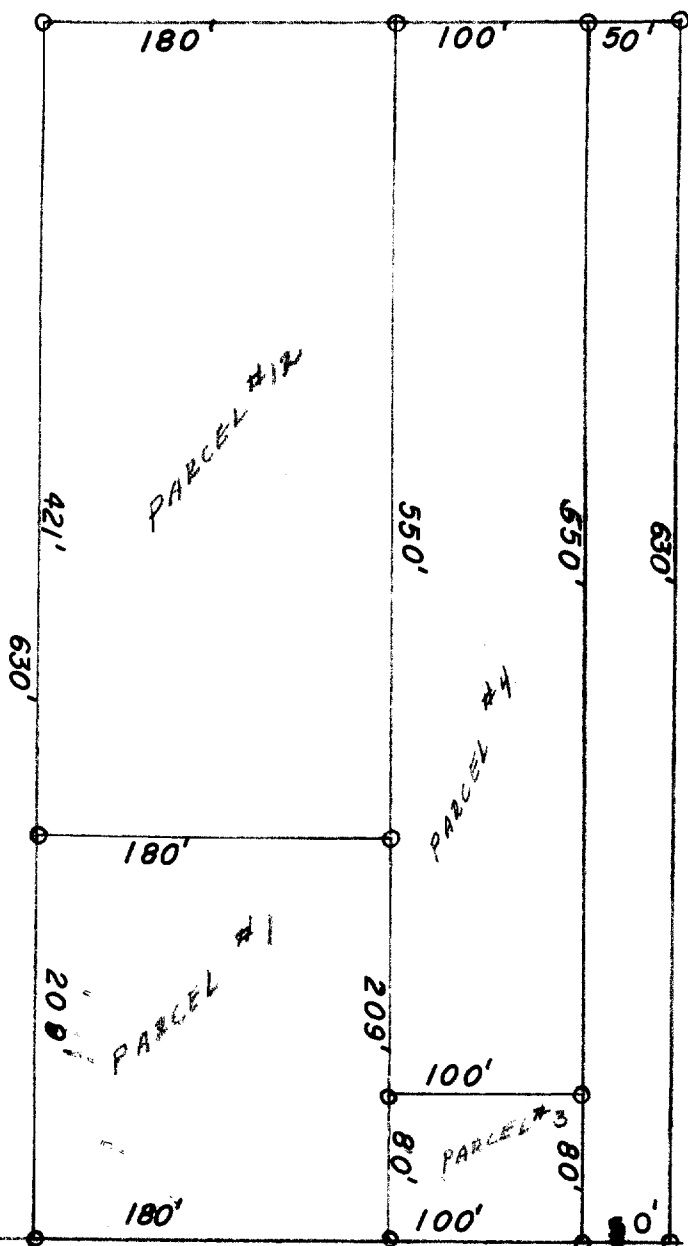

○ IRON STAKES

DESCRIPTIONS: Parcel #1. The South 209 feet of the West 180 feet of the East one half of the N.W. $\frac{1}{4}$ of the S.E. $\frac{1}{4}$ of the S.E. $\frac{1}{4}$ of Section 26, Town 2, north, Range 17 east of the 4th Principal Meridian.

Parcel #2, The North 421 feet of the West 180 feet of the East one half of the N.W. $\frac{1}{4}$ of the S.E. $\frac{1}{4}$ of the S.E. $\frac{1}{4}$ of Section 26, Town 2 north, Range 17 east of the 4th Principal Meridian.

CERTIFICATE: I, hereby certify that I have on this the 12th day of July 1957, surveyed the above described property, and the above drawn plat is a correct portrayal of said survey and that no encroachments exist.
SIGNED AND SEALED ON THIS THE 15TH DAY OF JULY 1957.

Joseph M. Biagi
Joseph M. Biagi. P.E.
Registered Surveyor
Elkhorn Wisconsin.

UP-47
UP-47A

57-88B.2