

## WALWORTH COUNTY SURVEYING & MAPPING LAKE GENEVA, WISCONSIN



## SHERIDAN STREET

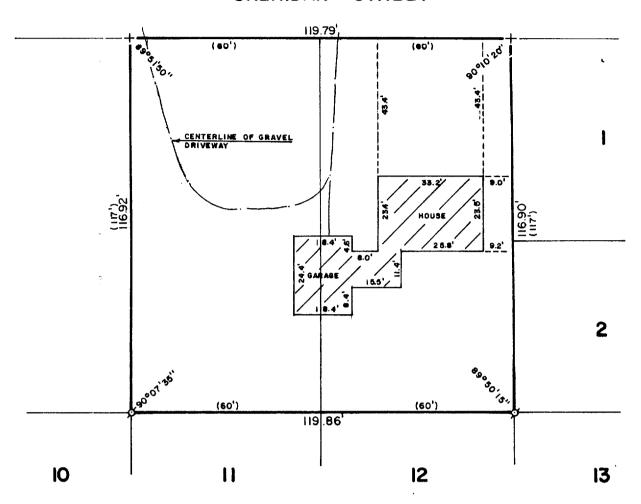

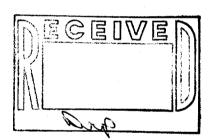

## PLAT OF SURVEY OF

LOTS 3 AND 4, BLOCK 1 OF WARHURST SUBDIVISION, LOCATED IN THE CITY OF LAKE GENEVA, WALWORTH COUNTY, WISCONSIN.

ORDERED BY: REALTY WORLD-TAGGART 736 MAIN STREET

LAKE GENEVA, WISCONSIN 53147



SCALE: 1"=30'

ø - IRON PIFE FOUND + - CUT CROSS IN CONCRETE FOUND

()-RECORDED AS

I, ROBERT M. BAERENWALD, DO HEREBY CERTIFY THAT I HAVE SURVEYED THE PROPERTY HEREON DESCRIBED ACCORDING TO THE OFFICIAL RECORDS AND THAT THE PLAT HEREON IS A CORRECT REPRESENTATION OF THE PROPERTY LINES TO THE BEST OF MY KNOWLEDGE AND BELIEF.

ROBERT M. BAERENWALD

WISCONSIN REGISTERED LAND SURVEYOR, S-1508

Oct. 6, 1986

DATE JOB NO. 0670

NOTE: THIS IS NOT A CERTIFIED COPY UNLESS SEALED.