


WALWORTH COUNTY  
SURVEYING & MAPPING  
LAKE GENEVA, WISCONSIN

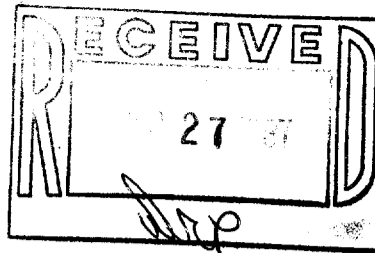

MAIN STREET

PLAT OF SURVEY OF

A PARCEL OF LAND RECORDED AS FOLLOWS:  
COMMENCING AT A POINT ON THE S. LINE  
OF MAIN STREET, IN THE CITY OF LAKE  
GENEVA, WALWORTH COUNTY, WISCONSIN,  
THAT IS 75.3\* E. OF THE E. LINE OF  
SEC. 35, T 2 N, R 17 E OF THE 4TH  
P. M., THENCE E. ALONG THE S. LINE  
OF SAID MAIN STREET 70.0 FEET TO AN  
IRON STAKE, THENCE S. 100.3 FEET,  
THENCE S63°42'W 33.85 FEET TO AN  
IRON STAKE, THENCE S. 193.2 FEET TO  
THE SHORE OF LAKE GENEVA, THENCE  
SW'LY ALONG THE SHORE OF LAKE GENEVA  
TO A POINT THAT IS S3°13'E OF THE  
PLACE OF BEGINNING 337.5 FEET, THENCE  
N3°13'W 337.5 FEET TO THE PLACE OF  
BEGINNING.

\*FEET

ORDERED BY: CLEWLOW REALTY  
803 MAIN STREET  
LAKE GENEVA, WISCONSIN



SCALE: 1"=30'

⊕ - IRON PIPE FOUND  
○ - IRON ROD PLACED  
( ) - RECORDED AS

I, ROBERT M. BAERENWALD, DO HEREBY CERTIFY THAT I  
HAVE SURVEYED THE PROPERTY HEREON DESCRIBED ACCORDING  
TO THE OFFICIAL RECORDS AND THAT THE PLAT HEREON IS A  
CORRECT REPRESENTATION OF THE PROPERTY LINES TO THE  
BEST OF MY KNOWLEDGE AND BELIEF.

*Robert M. Baerenwald*  
ROBERT M. BAERENWALD  
WISCONSIN REGISTERED LAND SURVEYOR, S-1508

DATE JAN. 19, 1987  
JOB NO. 0901

NOTE: THIS IS NOT A CERTIFIED COPY UNLESS SEALED.

(POINT LOCATED 75.3' EAST OF  
THE EAST LINE OF SECTION 35,  
T2N, R17E)

(EAST 70.0')  
69.90'

52.24'

SOUTH LINE OF MAIN STREET

S63°25'W

BLACKTOP DRIVEWAY

18.3'  
24.3'  
16.3'  
24.3'  
13.7'46"

GARAGE

34.2'  
29.7'  
7.4'  
13.3'  
13.3'  
9.6'

HOUSE

S60°02'10"W

100.36'  
(SOUTH 100.3')

3388'  
(S63°42'W 33.85')

160.00'  
193.00'  
(SOUTH 193.2')

1.21'

(S3°13'W 337.5')  
343.65'

156.38'

0.4'

0.6'

FOUNDATION

148°31'40"

69.39'

32°02'18"

50'

GENEVA LAKE

24UP-94Q

17-890