


98-63

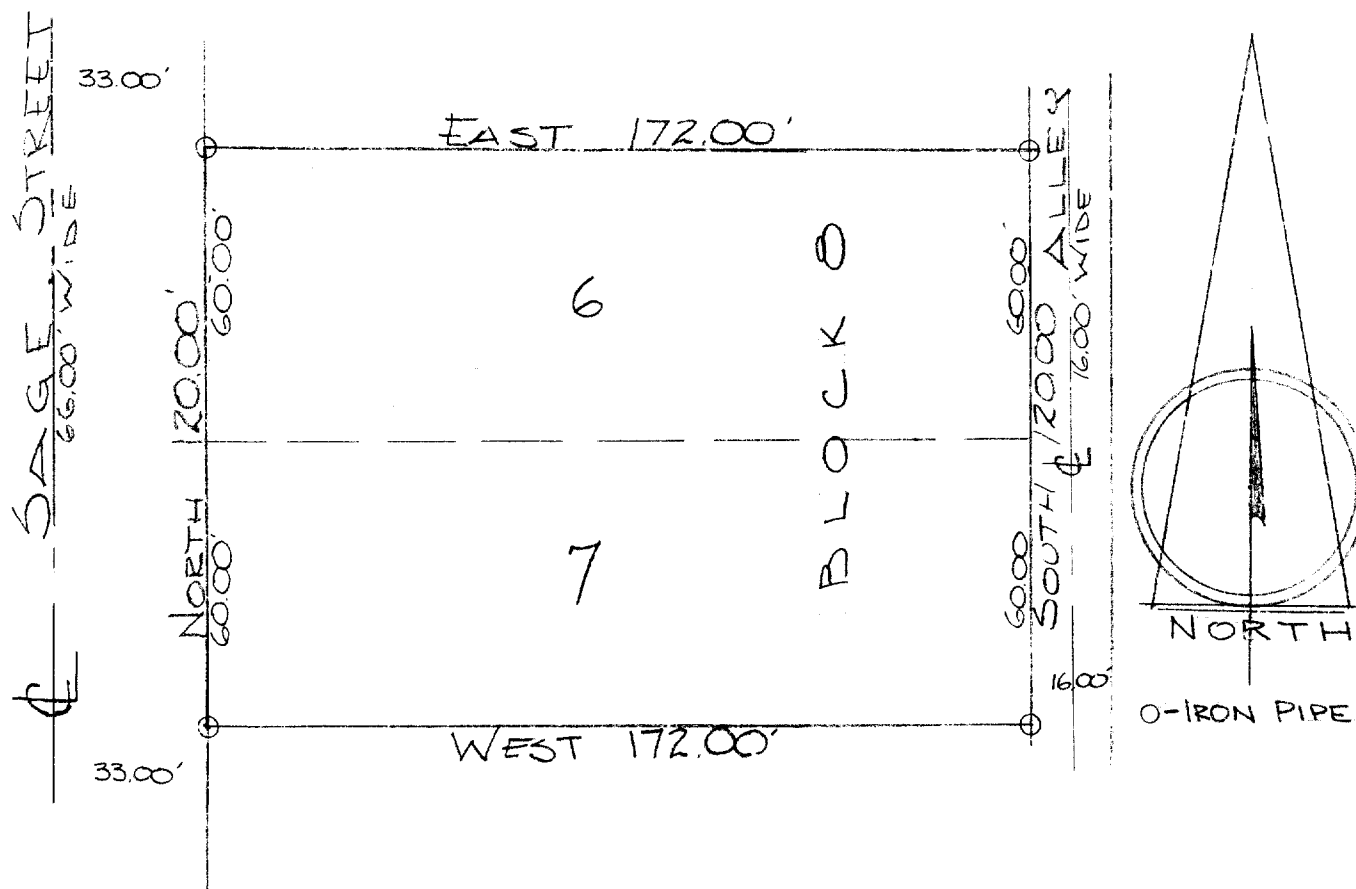


DESCRIPTION:

Lots 6 & 7 Block 8 of Geneva Lake Crawford Manufacturing Company
Addition to the City of Lake Geneva, Walworth County, Wisconsin.

CERTIFICATE:

I, James F. Biagi Surveyor, do hereby certify that I have surveyed
the property hereon described and portrayed on this the 13th day of August 1963.

Signed and sealed on this the 14th day of August, 1963.

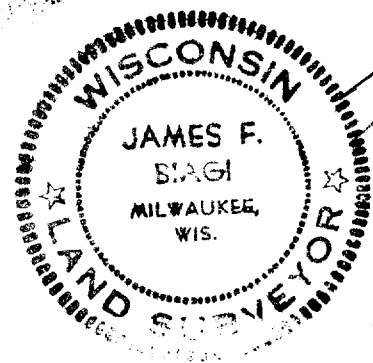

James F. Biagi, P.E.
ELS 272 Wisconsin.
Elkhorn, Wisconsin.

266 S.A.B.A?

7-89B