
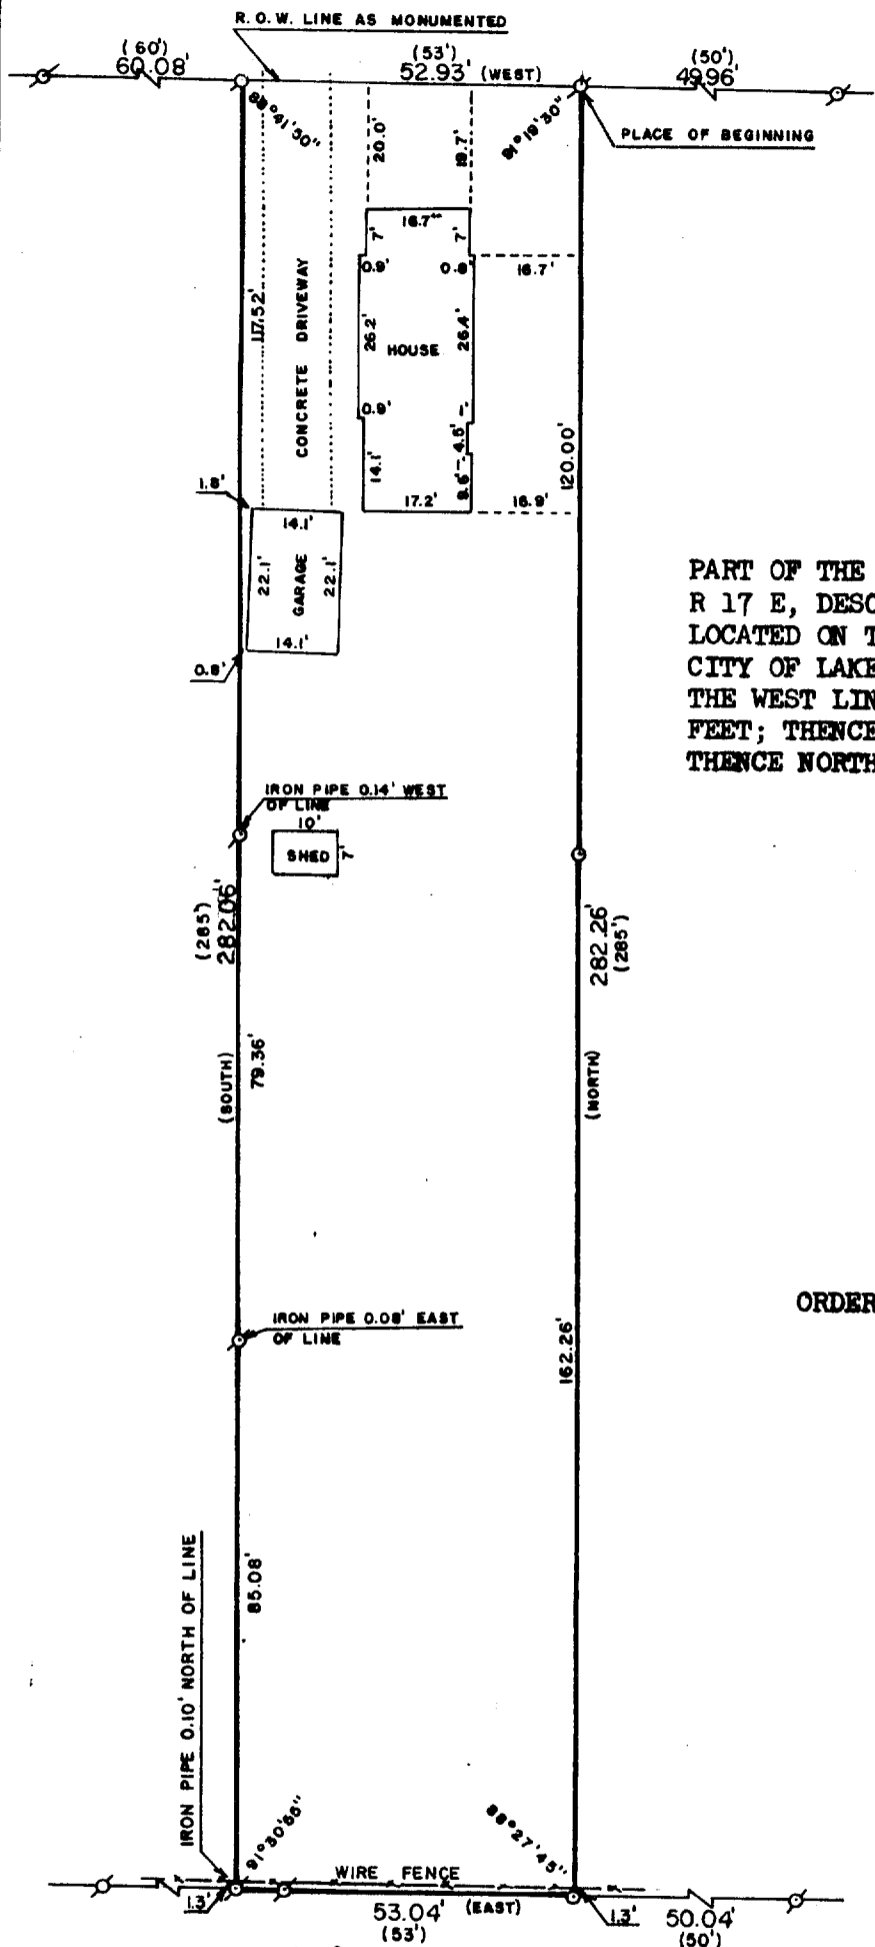


WALWORTH COUNTY
SURVEYING & MAPPING
LAKE GENEVA, WISCONSIN

DODGE STREET

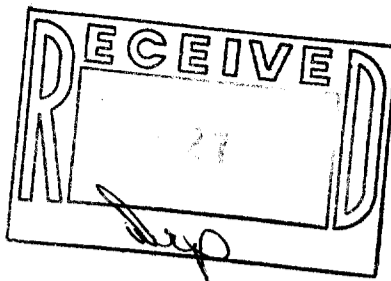

PLAT OF SURVEY OF

PART OF THE NORTHEAST 1/4 OF SECTION 35, T 2 N,
R 17 E, DESCRIBED AS FOLLOWS: BEGIN AT A POINT
LOCATED ON THE SOUTH LINE OF DODGE STREET IN THE
CITY OF LAKE GENEVA, WHICH IS 445 FEET WEST OF
THE WEST LINE OF ELMWOOD AVENUE, THENCE WEST 53
FEET; THENCE SOUTH 285 FEET; THENCE EAST 53 FEET;
THENCE NORTH 285 FEET TO THE PLACE OF BEGINNING.

ORDERED BY: REDELL REALTY
506 MADISON STREET
LAKE GENEVA, WISCONSIN 53147

STURWOOD ADD. NO. 5



SCALE: 1"=30'

- ⊙ - IRON PIPE FOUND
- - IRON ROD PLACED
- () - RECORDED AS

I, ROBERT M. BAERENWALD, DO HEREBY CERTIFY THAT I
HAVE SURVEYED THE PROPERTY HEREON DESCRIBED ACCORDING
TO THE OFFICIAL RECORDS AND THAT THE PLAT HEREON IS A
CORRECT REPRESENTATION OF THE PROPERTY LINES TO THE
BEST OF MY KNOWLEDGE AND BELIEF.

Robert M. Baerenwald
ROBERT M. BAERENWALD
WISCONSIN REGISTERED LAND SURVEYOR, S-1508

Feb. 3, 1987
DATE JOB NO. 0911

NOTE: THIS IS NOT A CERTIFIED COPY UNLESS SEALED.

ZYUP-61

7-923