


WALWORTH COUNTY SURVEYING & MAPPING LAKE GENEVA, WISCONSIN

## ROW PARK

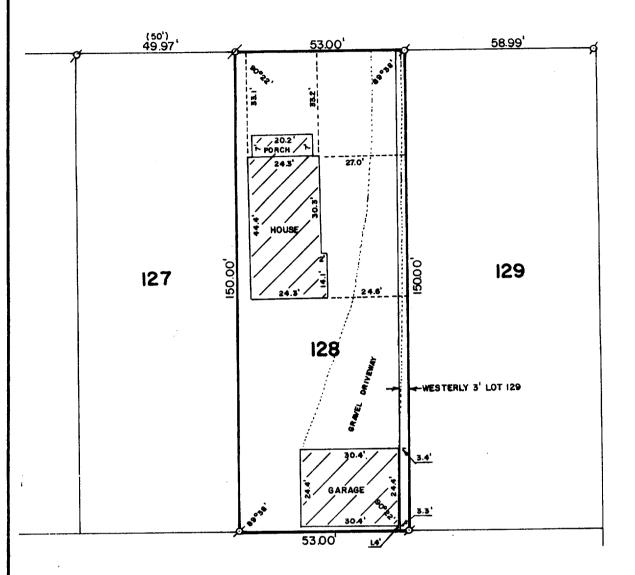

WARREN STREET

## PLAT OF SURVEY OF

LOT 128 AND THE WESTERLY 3 FEET OF LOT 129 OF COLUMBIAN SUBDIVISION, LOCATED IN THE CITY OF LAKE GENEVA, WALWORTH COUNTY, WISCONSIN.

ORDERED BY: REALTY WORLD-TAGGART

736 MAIN STREET

LAKE GENEVA, WISCONSIN 53147

I, ROBERT M. BAERENWALD, DO HEREBY CERTIFY THAT I HAVE SURVEYED THE PROPERTY HEREON DESCRIBED ACCORDING TO THE OFFICIAL RECORDS AND THAT THE PLAT HEREON IS A CORRECT REPRESENTATION OF THE PROPERTY LINES TO THE



SCALE: 1"=30'

ø - IRON PIPE FOUND

ø - IRON ROD FOUND ()-RECORDED AS

ROBERT M. BAERENWALD

WISCONSIN REGISTERED LAND SURVEYOR, S-1508

DATE JOB NO. 0925

BEST OF MY KNOWLEDGE AND BELIEF.

NOTE: THIS IS NOT A CERTIFIED COPY UNLESS SEALED.

2CL-96