


52-22

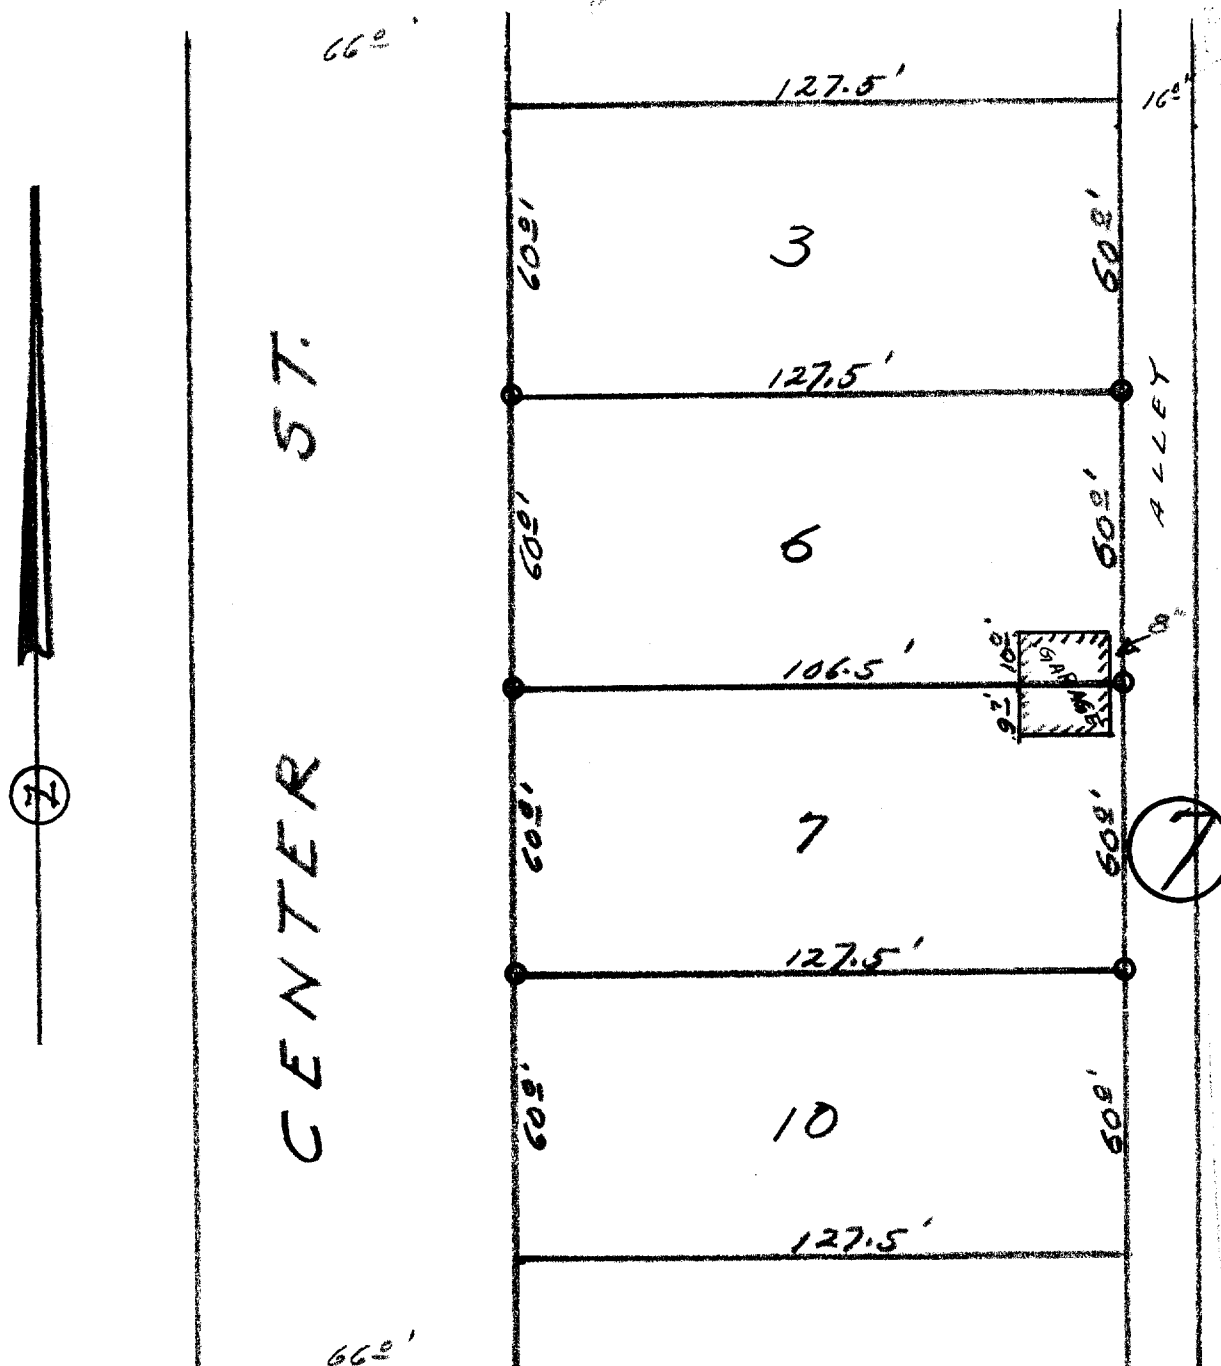

DESCRIPTION: Lots 6 and 7 Block 7, Geneva Lake Crawford Manufacturer's Company Addition to the City of Lake Geneva, Walworth County Wisconsin.

CERTIFICATE: I, hereby certify that I have on this the 10th day of April 1952, surveyed the above described property according to the official records on file in the office of the Recorder of Deeds in and for Walworth County, Wisconsin, and find that measurements and bearings of the boundary lines of said property as taken at the site on this day, substantially agree with those in said official record and that the garage shown encroaches 10.0 feet on lot 6, and 9.7 feet on lot 10.

SIGNED AND SEALED ON THIS THE 11TH DAY OF APRIL 1952.

Joseph M. Blagi
Joseph M. Blagi. Professional Engineer.
Elkhorn Wisconsin.

7-92B