


**HAROLD H. KOLB**  
REGISTERED PROFESSIONAL LAND SURVEYOR  
LAKE GENEVA, WISCONSIN



DESCRIPTION OF

A parcel of land located in the Northwest  $\frac{1}{4}$  of Section 6, T 1 N R 18 E, Walworth County, Wisconsin and described as follows; to-wit: Commencing at the center of said Section 6, thence N 2° 53' W 751.80 feet to the Southeasterly right-of-way line of the Chicago and Northwestern railroad; thence N 40° 06' W 462.74 feet along said right-of-way to the place of beginning; thence S 85° 56' W 1504.29 feet to the centerline of County Trunk Highway H; thence N 33° 36' W 1222.79 feet along said centerline; thence S 89° 58' E 1408.10 feet to said railroad right-of-way; thence S 40° 06' E along said right-of-way 1191.95 feet to the place of beginning.

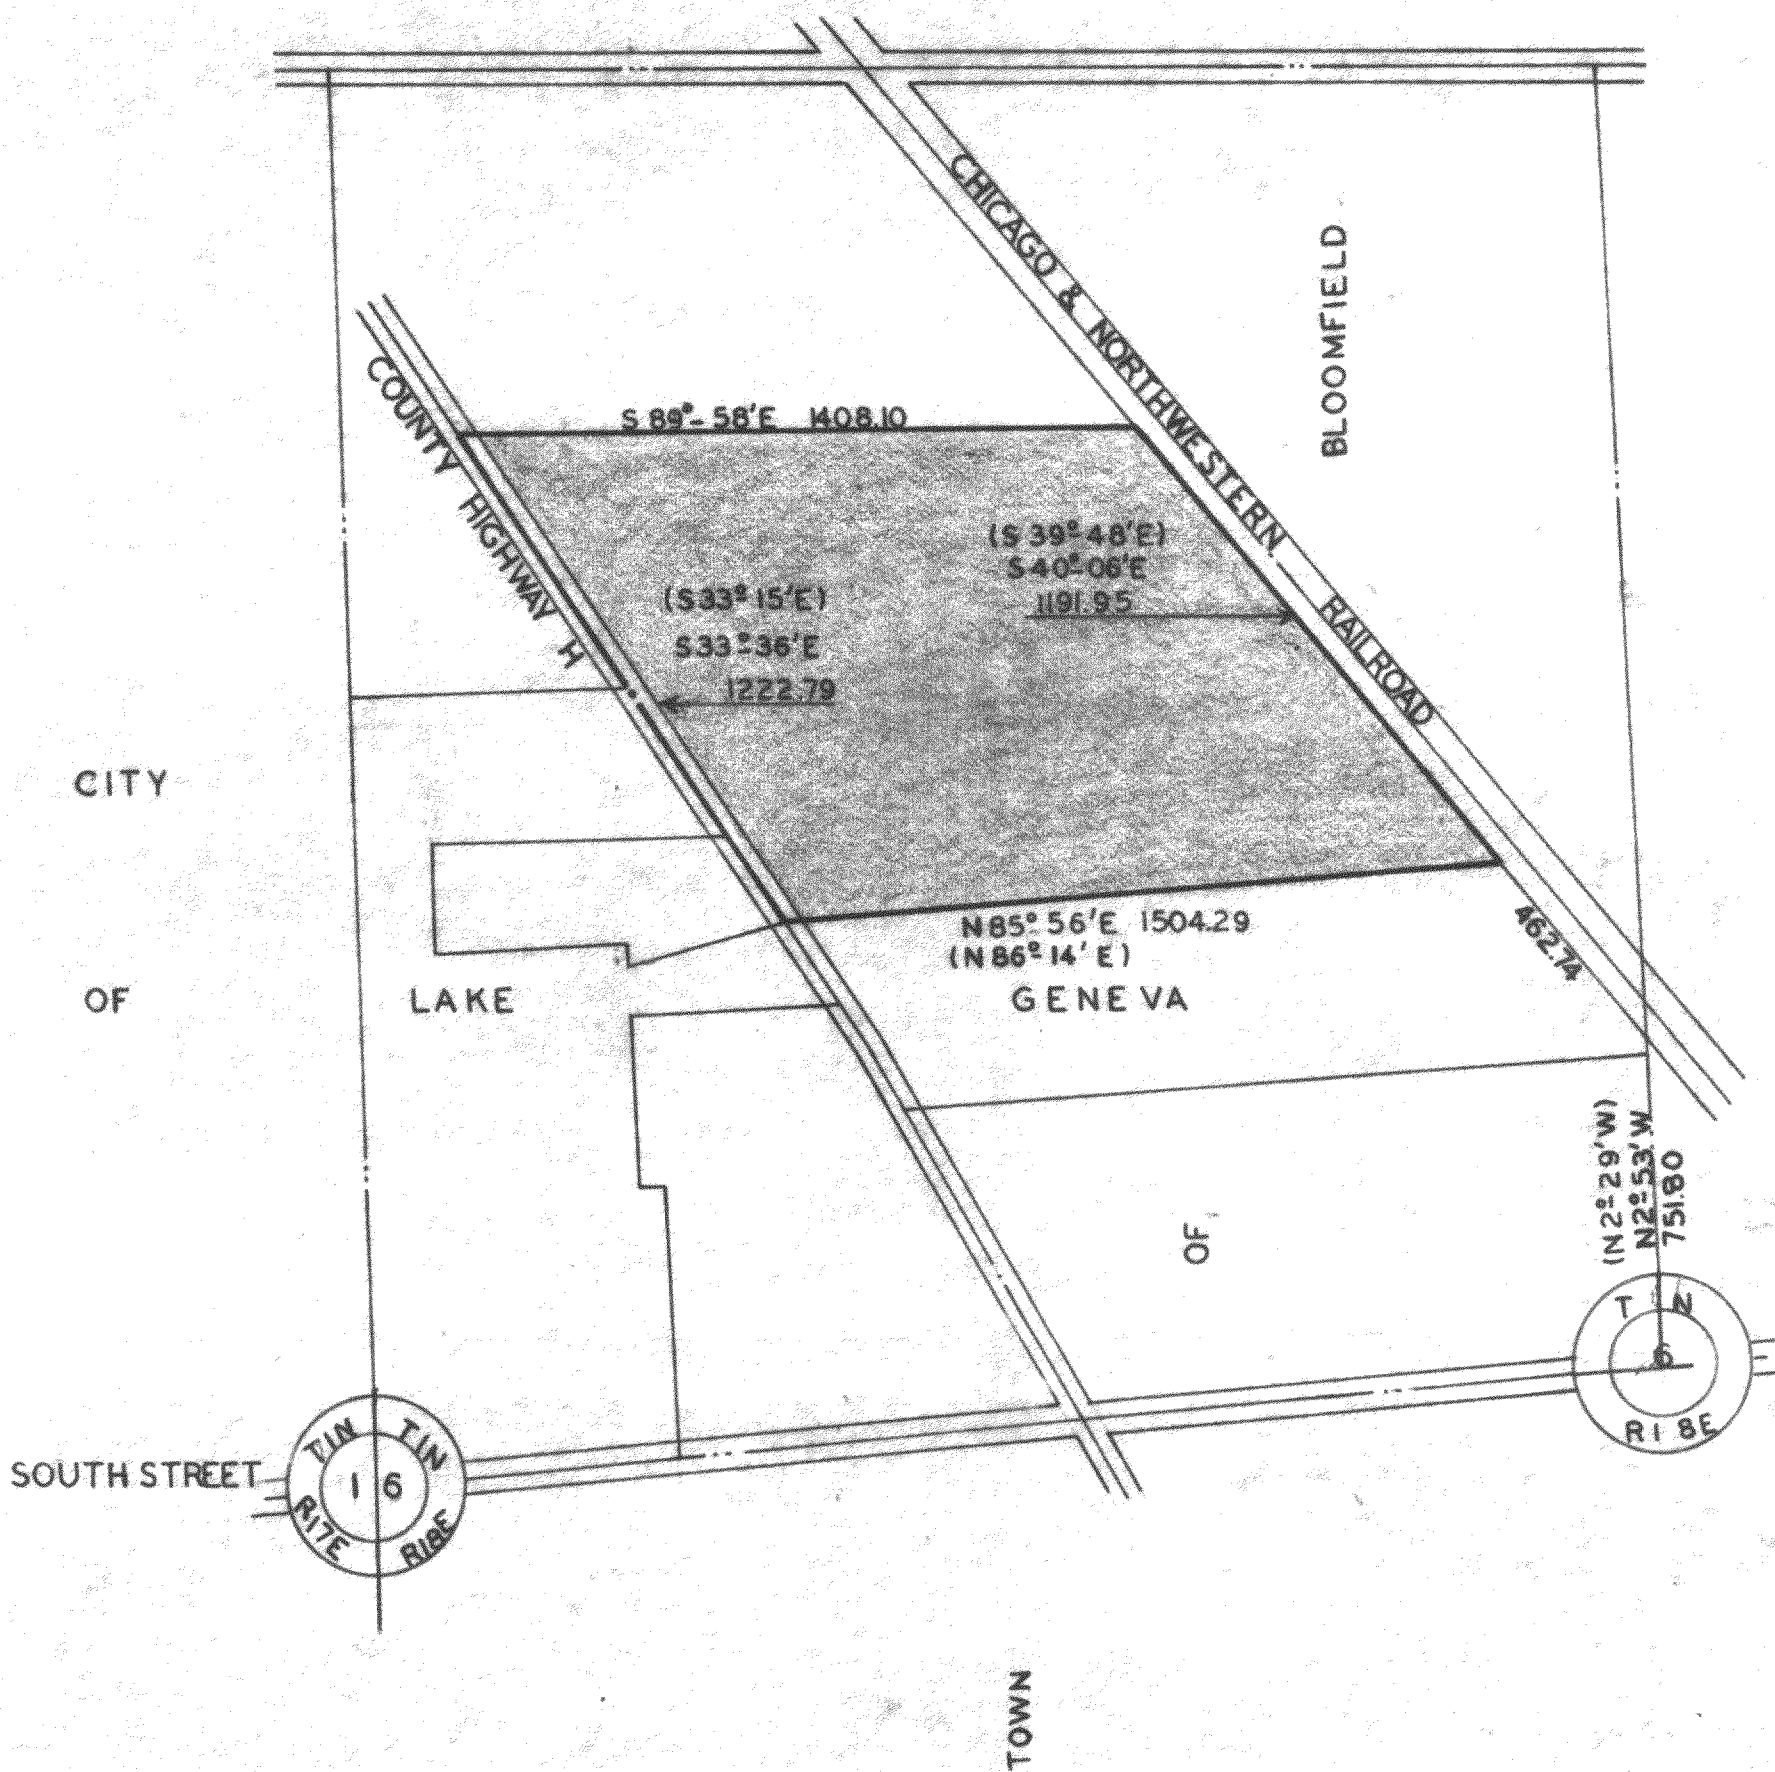


LEGEND

- — IRON PIPE FOUND
- — IRON PIPE PLACED
- — CONCRETE MONUMENT
- x — SPIKE

SCALE 1"=400'

( ) AS PLATTED

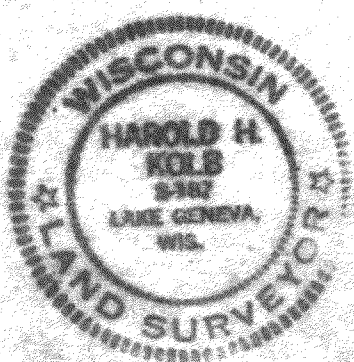

I, HAROLD H. KOLB, DO HEREBY CERTIFY THAT I HAVE SURVEYED THE PROPERTY HEREON DESCRIBED ACCORDING TO THE OFFICIAL RECORDS, AND THAT THE PLAT HEREON IS A CORRECT REPRESENTATION OF THE LOT LINES.

*Harold H. Kolb*

HAROLD H. KOLB  
WISCONSIN REGISTERED LAND SURVEYOR, S-187  
DATE \_\_\_\_\_