



WALWORTH COUNTY  
SURVEYING & MAPPING  
LAKE GENEVA, WISCONSIN

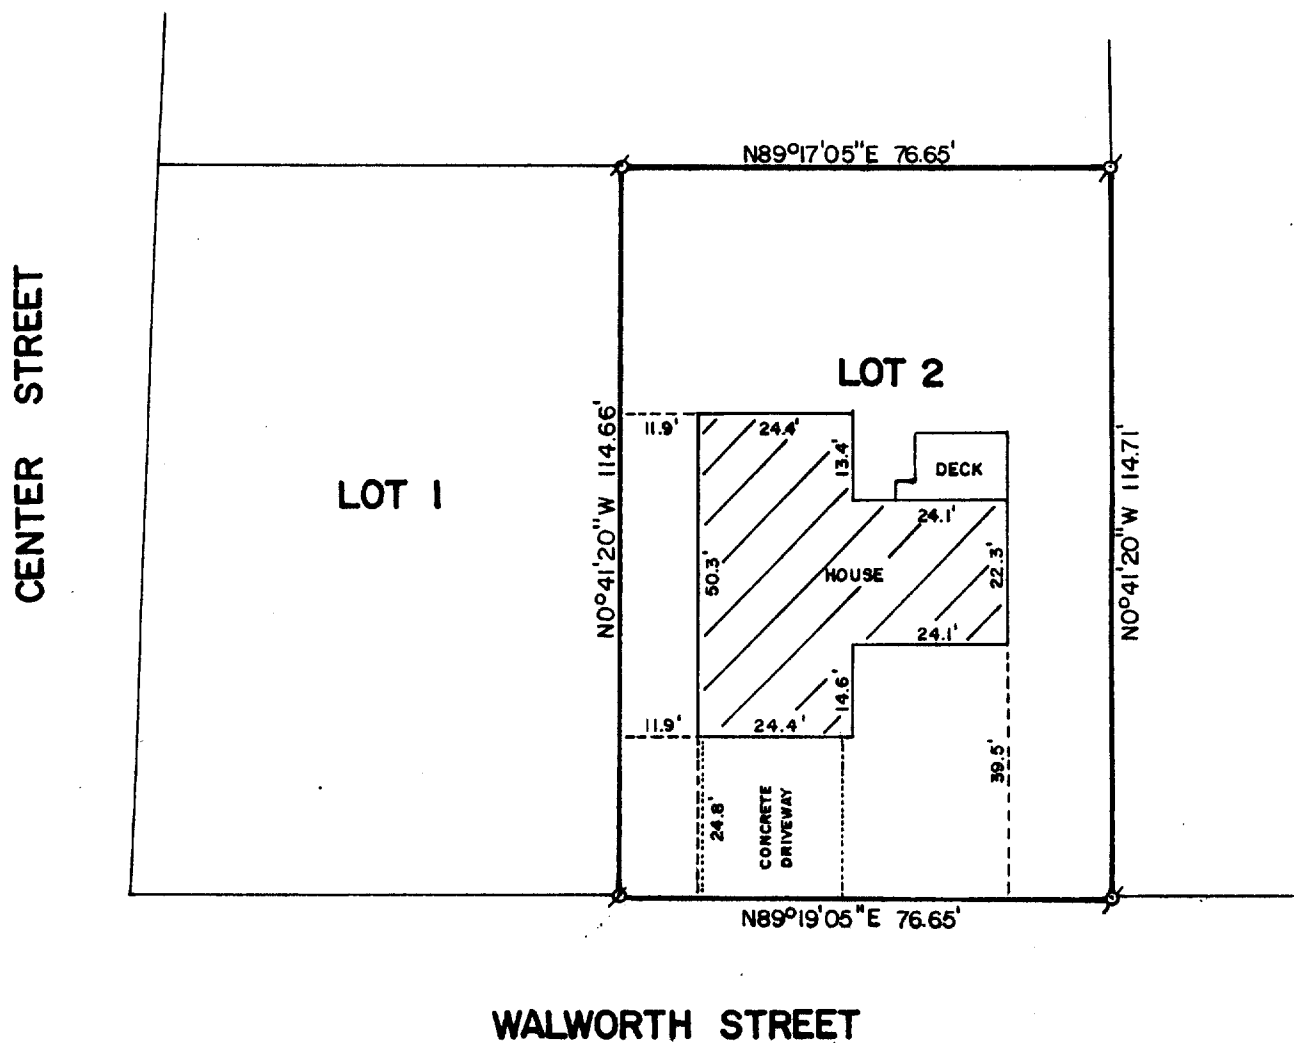

PLAT OF SURVEY OF

LOT 2 OF CERTIFIED SURVEY MAP NO.  
1454, LOCATED IN THE CITY OF LAKE  
GENEVA, WALWORTH COUNTY, WISCONSIN.

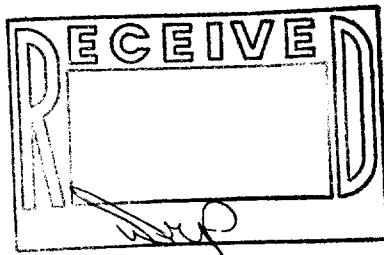

ORDERED BY: DAVE TWIST  
811 CENTER STREET  
LAKE GENEVA, WISCONSIN



SCALE: 1"=30'

⊘ - IRON PIPE FOUND  
⊘ - IRON ROD FOUND

I, ROBERT M. BAERENWALD, DO HEREBY CERTIFY THAT I  
HAVE SURVEYED THE PROPERTY HEREON DESCRIBED ACCORDING  
TO THE OFFICIAL RECORDS AND THAT THE PLAT HEREON IS A  
CORRECT REPRESENTATION OF THE PROPERTY LINES TO THE  
BEST OF MY KNOWLEDGE AND BELIEF.

*Robert M. Baerenwald*  
ROBERT M. BAERENWALD  
WISCONSIN REGISTERED LAND SURVEYOR, S-1508

*Aug. 20, 1987*  
DATE JOB NO. 0425

NOTE: THIS IS NOT A CERTIFIED COPY UNLESS SEALED.