7 RIDGEWAY COURT, P.O. BOX 487, ELKHORN, WISCONSIN

TEL. 414-723-2098

LOCATION: LOT 1 OF CERTIFIED SURVEY MAP NO. 1619 IN

THE CITY OF LAKE GENEVA, WALMORTH CO., WI.

WORK ORDERED BY: BANK OF FORT ATKINSON

MAP SCALE IN FEET


MAP LEGEND

= IRON PIPE STAKE FOUND = IRON PIPE STAKE SET

O = IRON ROD STAKE FOUND = IRON ROD STAKE SET

- CONCRETE MONUMENT FOUND

( XXXXX )= RECORD DIMENSION

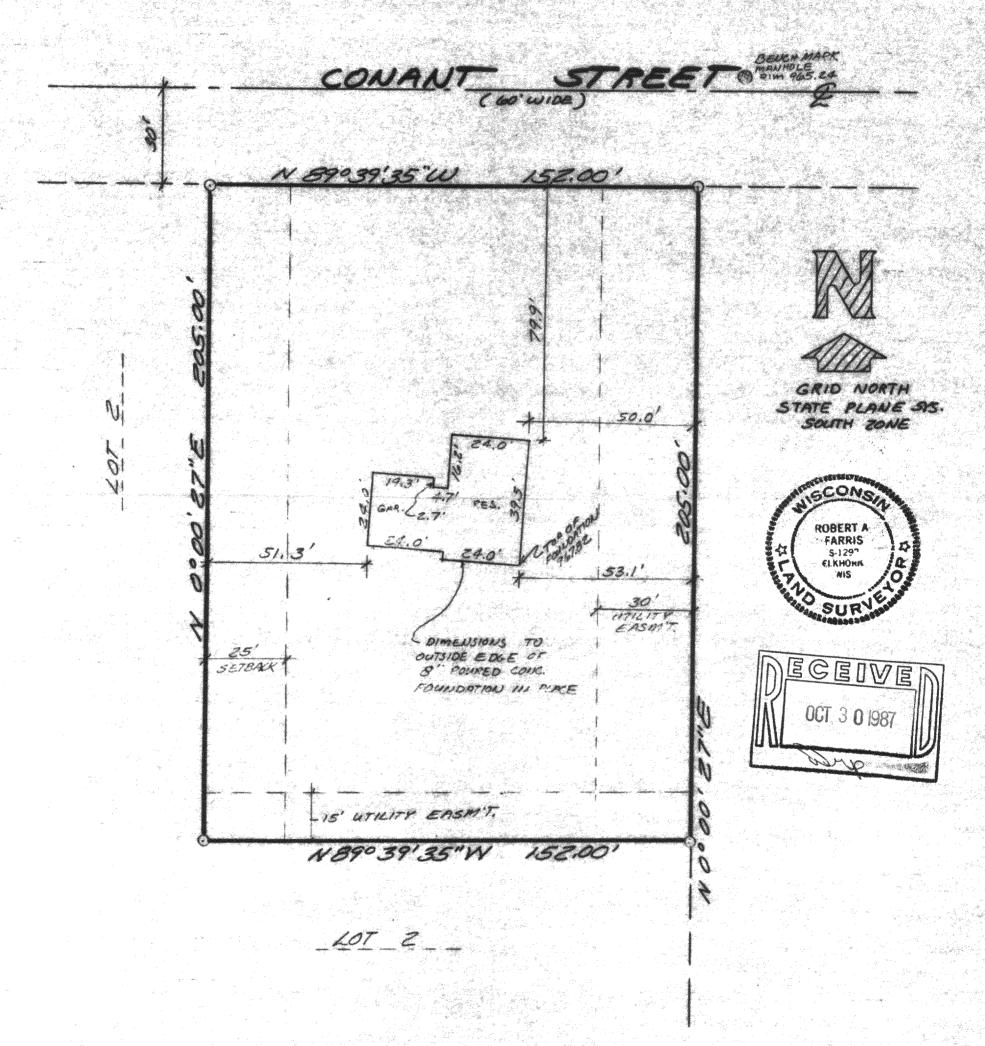

I hereby certify that the above described property has been surveyed under my direction and that the above map is a true representation thereof and shows the size and location of the property, its exterior boundaries, and the location of all visible structures.

This survey is made for the use of the present owners of the property, and also those who purchase, mortgage, or guarantee the title thereto within one year from the date hereof,

