

## WALWORTH COUNTY SURVEYING & MAPPING LAKE GENEVA, WISCONSIN

## WISCONSIN STREET

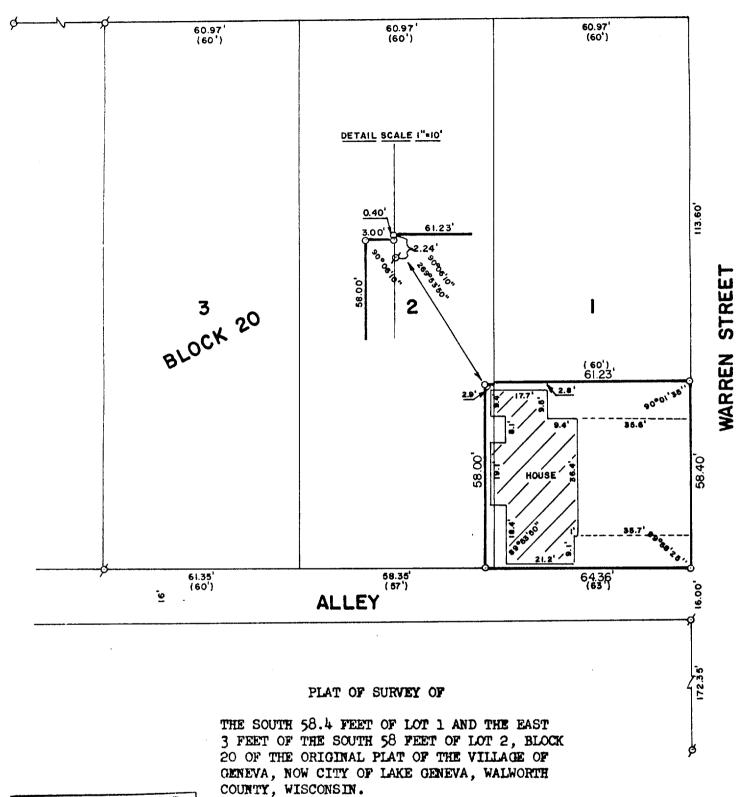

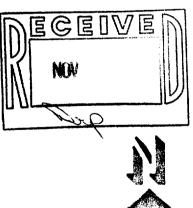

SCALE: 1"=30'

ø -IRON PIPE FOUND o -IRON ROD PLACED

()-RECORDED AS

ORDERED BY: CENTURY 21 GENEVA LAKE 503 CENTER STREET

LAKE GENEVA, WISCONSIN 53147

I, ROBERT M. BAERENWALD, DO HEREBY CERTIFY THAT I HAVE SURVEYED THE PROPERTY HEREON DESCRIBED ACCORDING TO THE OFFICIAL RECORDS AND THAT THE PLAT HEREON IS A CORRECT REPRESENTATION OF THE PROPERTY LINES TO THE BEST OF MY KNOWLEDGE AND BELIEF.

ROBERT M. BAERENWALD
WISCONSIN REGISTERED LAND SURVEYOR, S-1508

Oct. 27,1987

JOB NO. 1297

NOTE: THIS IS NOT A CERTIFIED COPY UNLESS SEALED.