


51-16

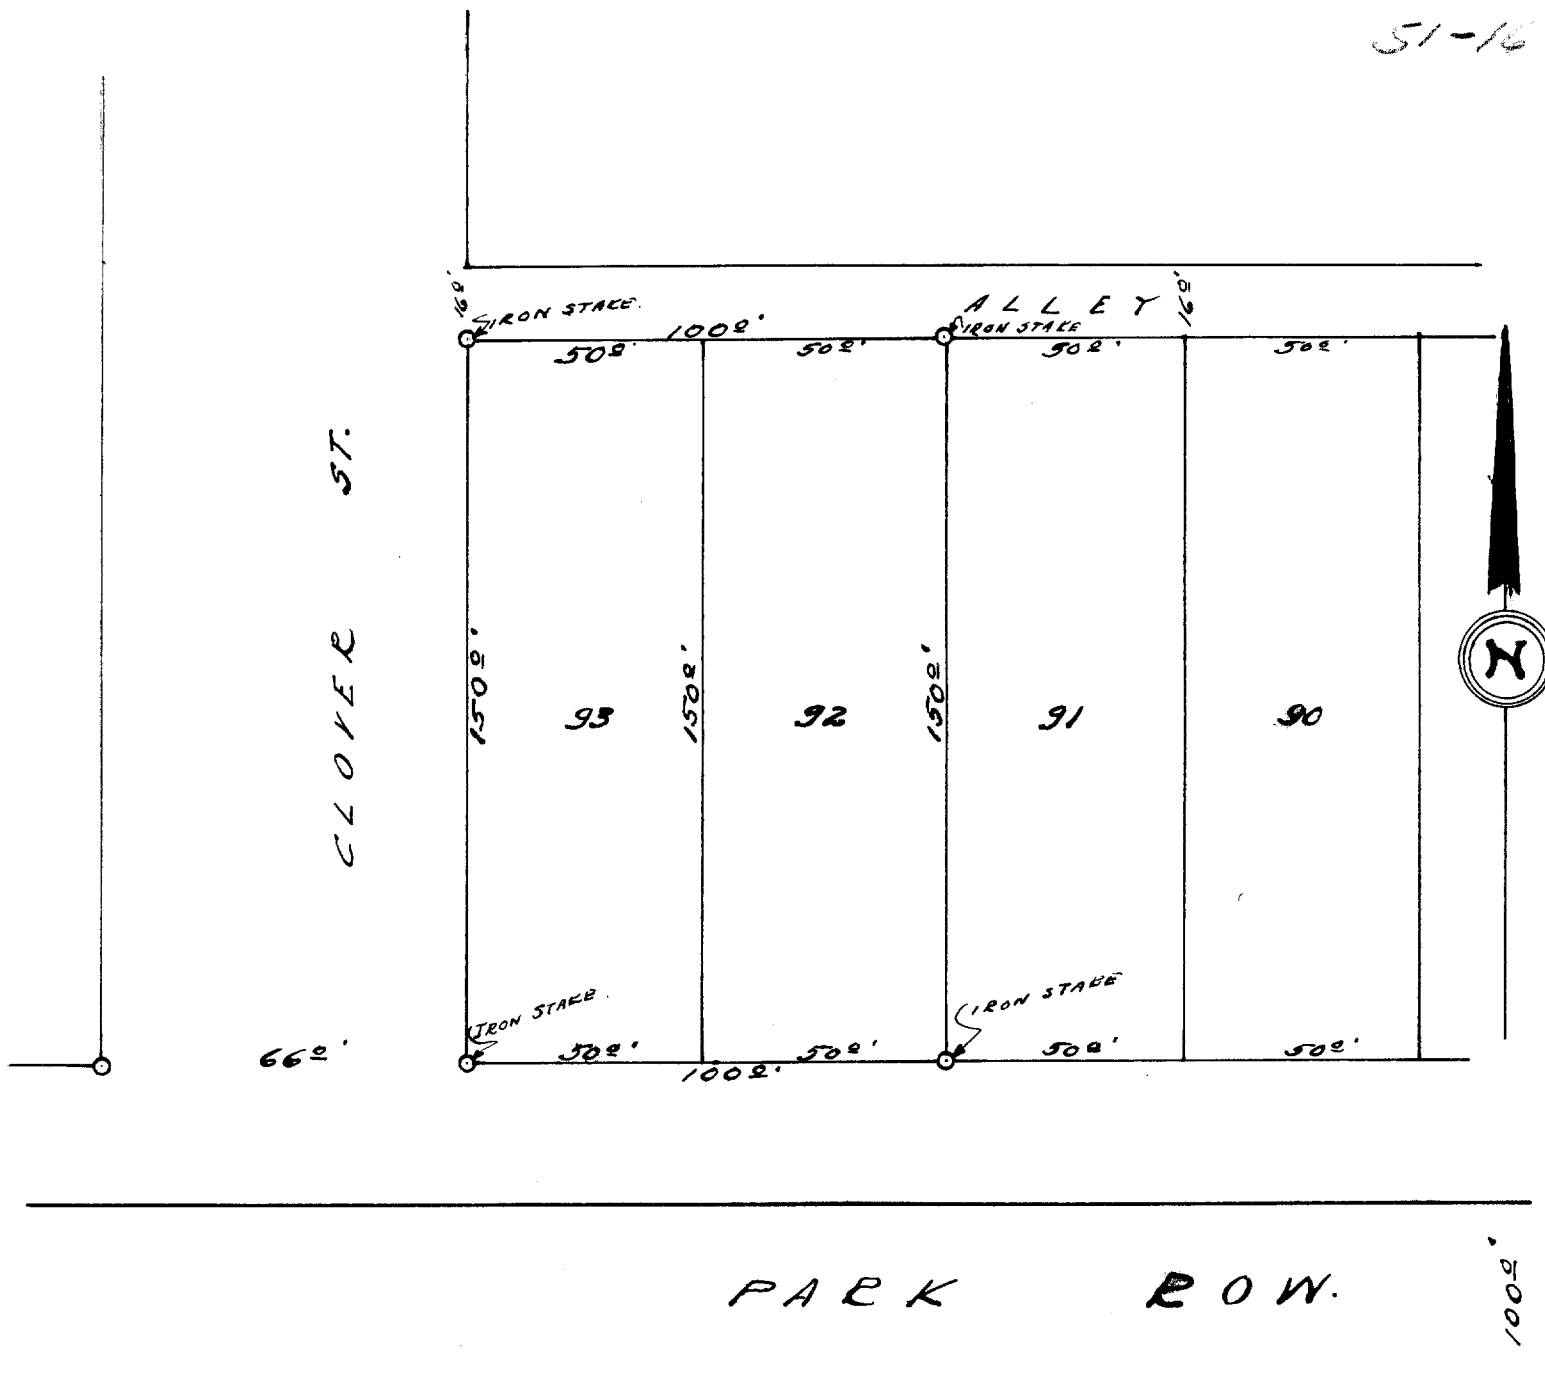

DESCRIPTION:

Lots 92 and 93 Columbian Subdivision of a portion of the City of Lake Geneva, Walworth County, Wisconsin.

CERTIFICATE:

I, hereby certify that I have on this the 20th day of June 1951. surveyed the above described property according to the official plat on file in the office of the Recorder of Deeds in and for Walworth County, and find that the measurements and bearings of the boundary lines of said property as taken at the site on this day substantially agree with said official plat and that no encroachments exist.

SIGNED AND SEALED ON THIS THE 22ND DAY OF JUNE 1951.

Joseph M. Biagi. Professional Engineer
Elkhorn Wisconsin.