


GRACE STREET 66' WIDE

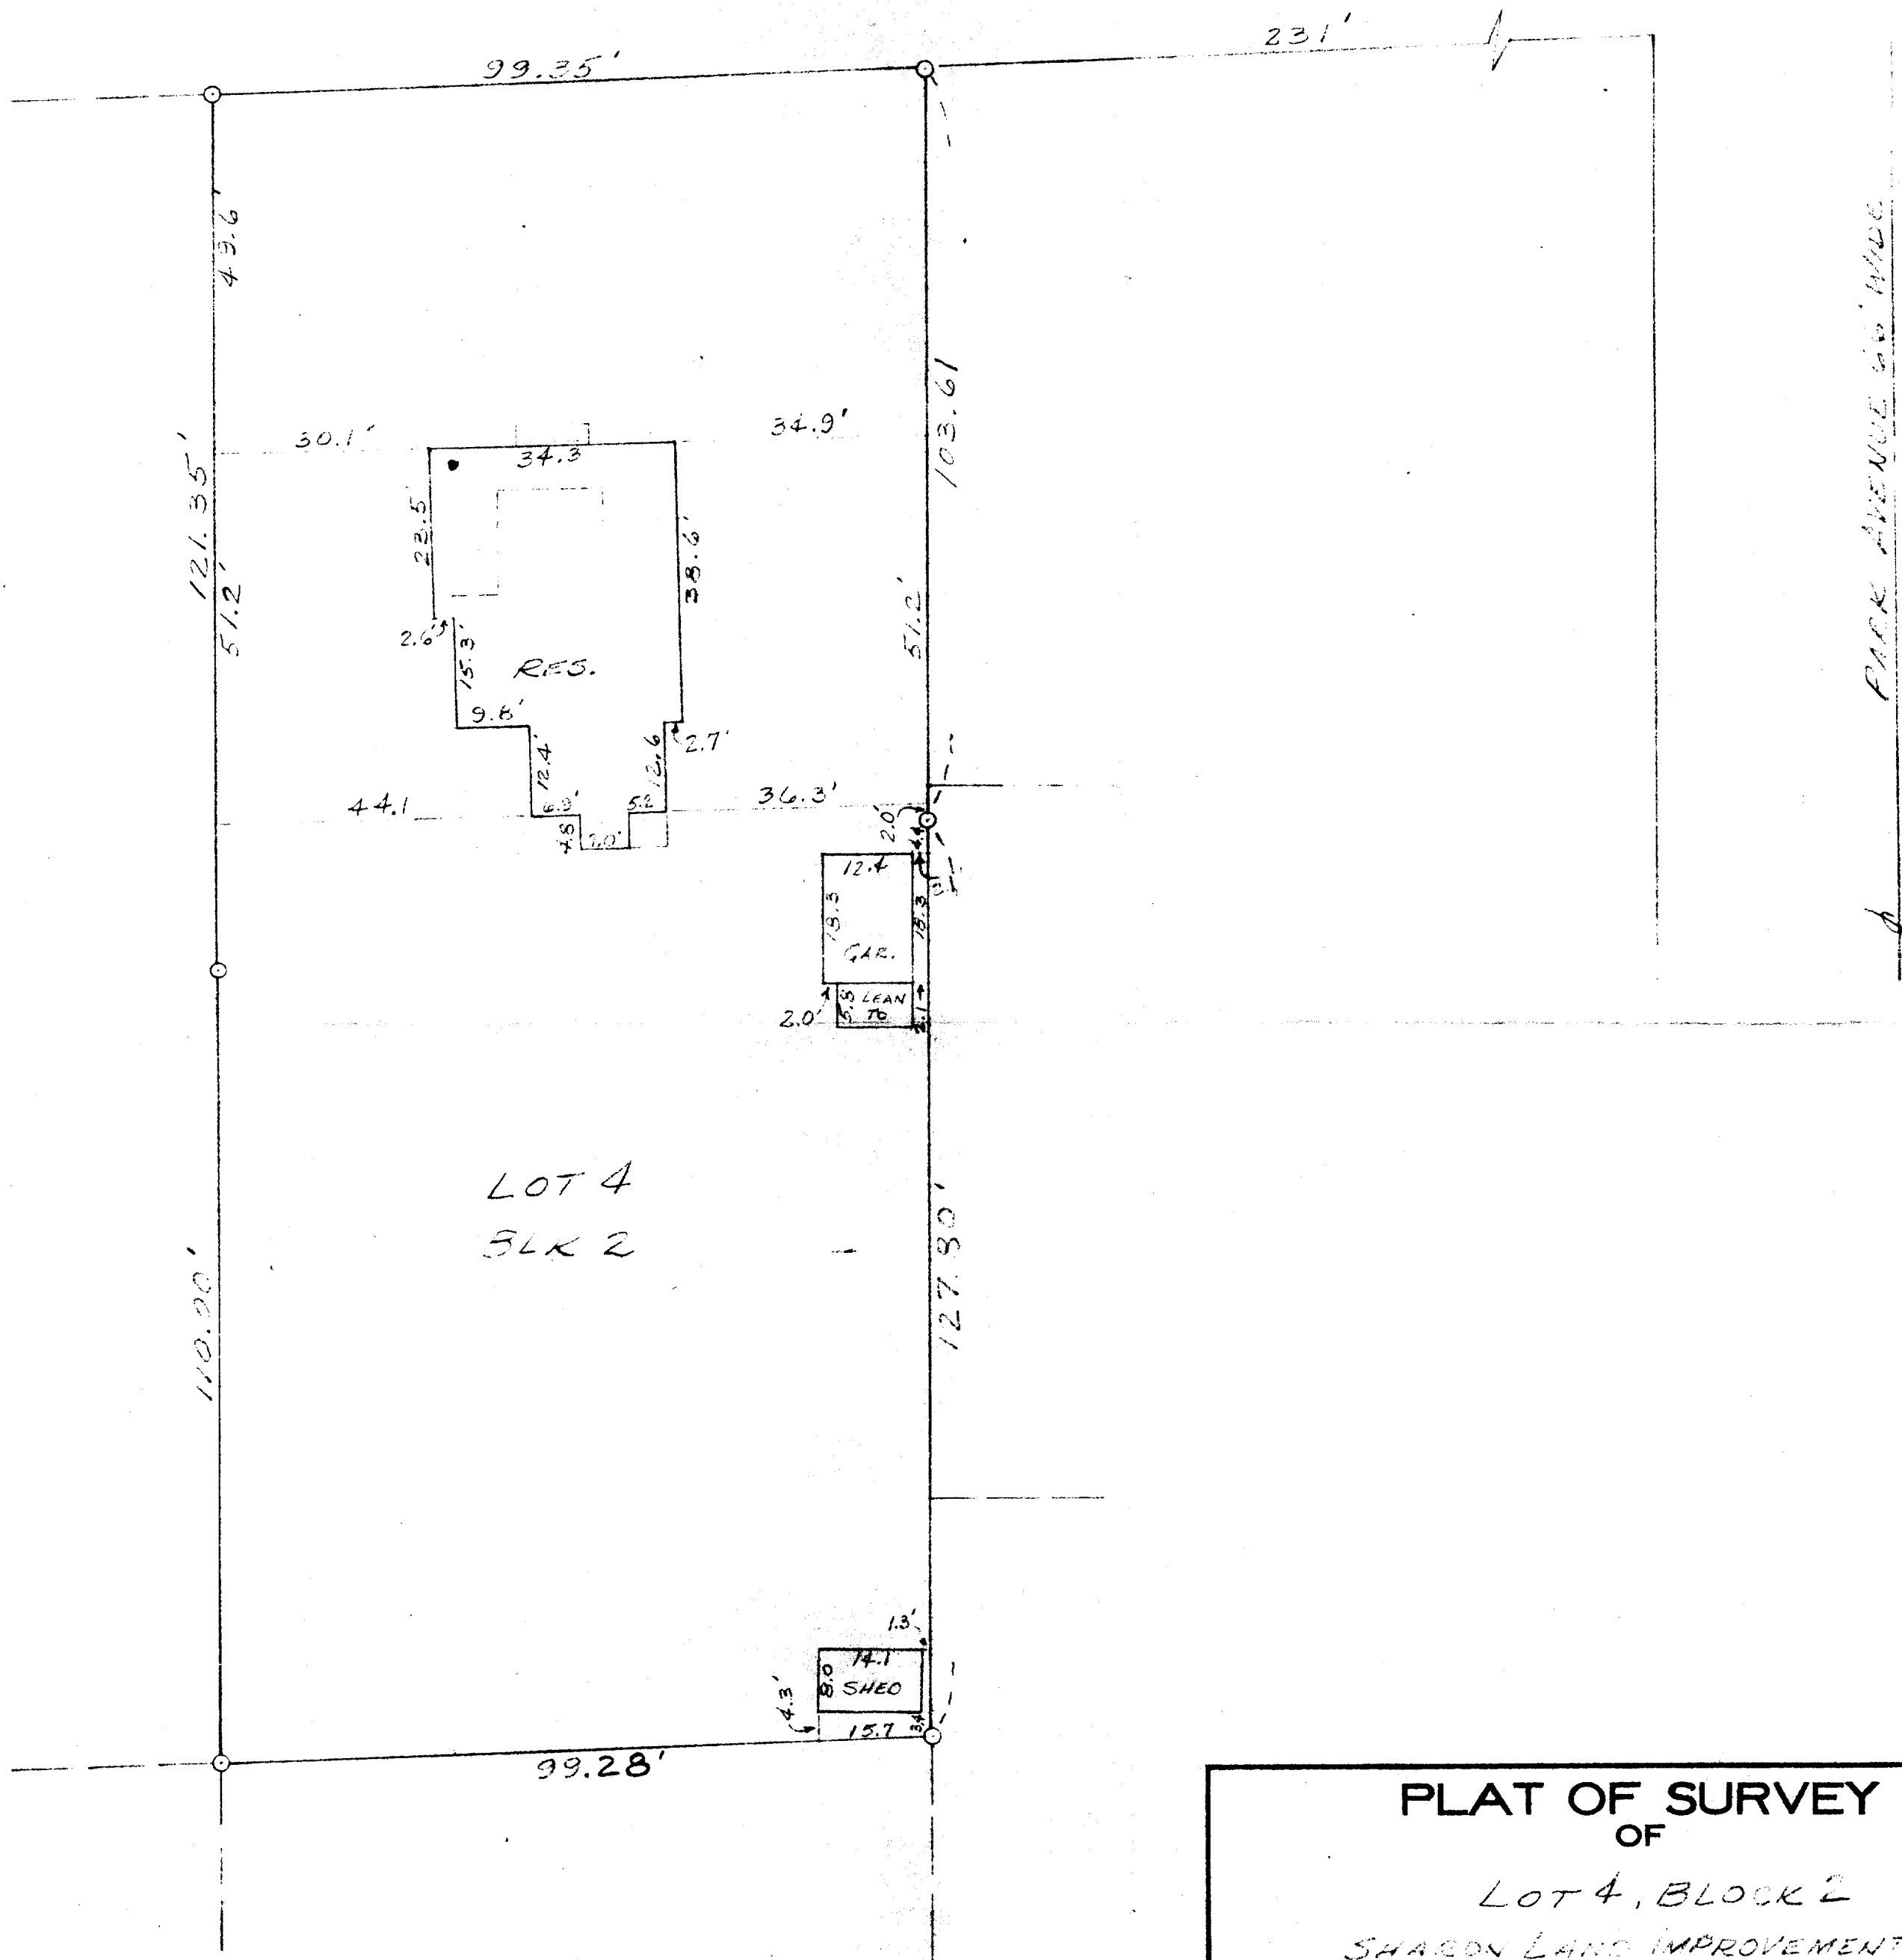

PLAT OF SURVEY
OF

LOT 4, BLOCK 2
SHARON LAND IMPROVEMENT ADD
VILLAGE OF SHARON, WALWORTH CO.,
WISCONSIN

Lloyd L. Jensen
SURVEYOR

— IRON PIPE

8-105

SCALE 1" = 20'

DATE July 1961

U.S.L.I.-11