



Centerline of
PLEASANT STREET

DUNHAM SURVEYING, S.C.
SURVEYING & SUBDIVIDING
DELAVAN, WISCONSIN 53115

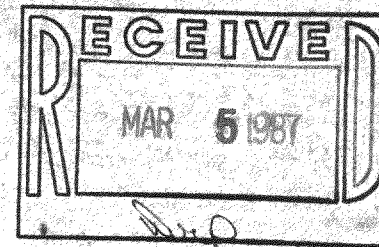

Iron Pipe Found 11/17/86
0.7' West of correct corner.
Did not remove because of
frozen ground.

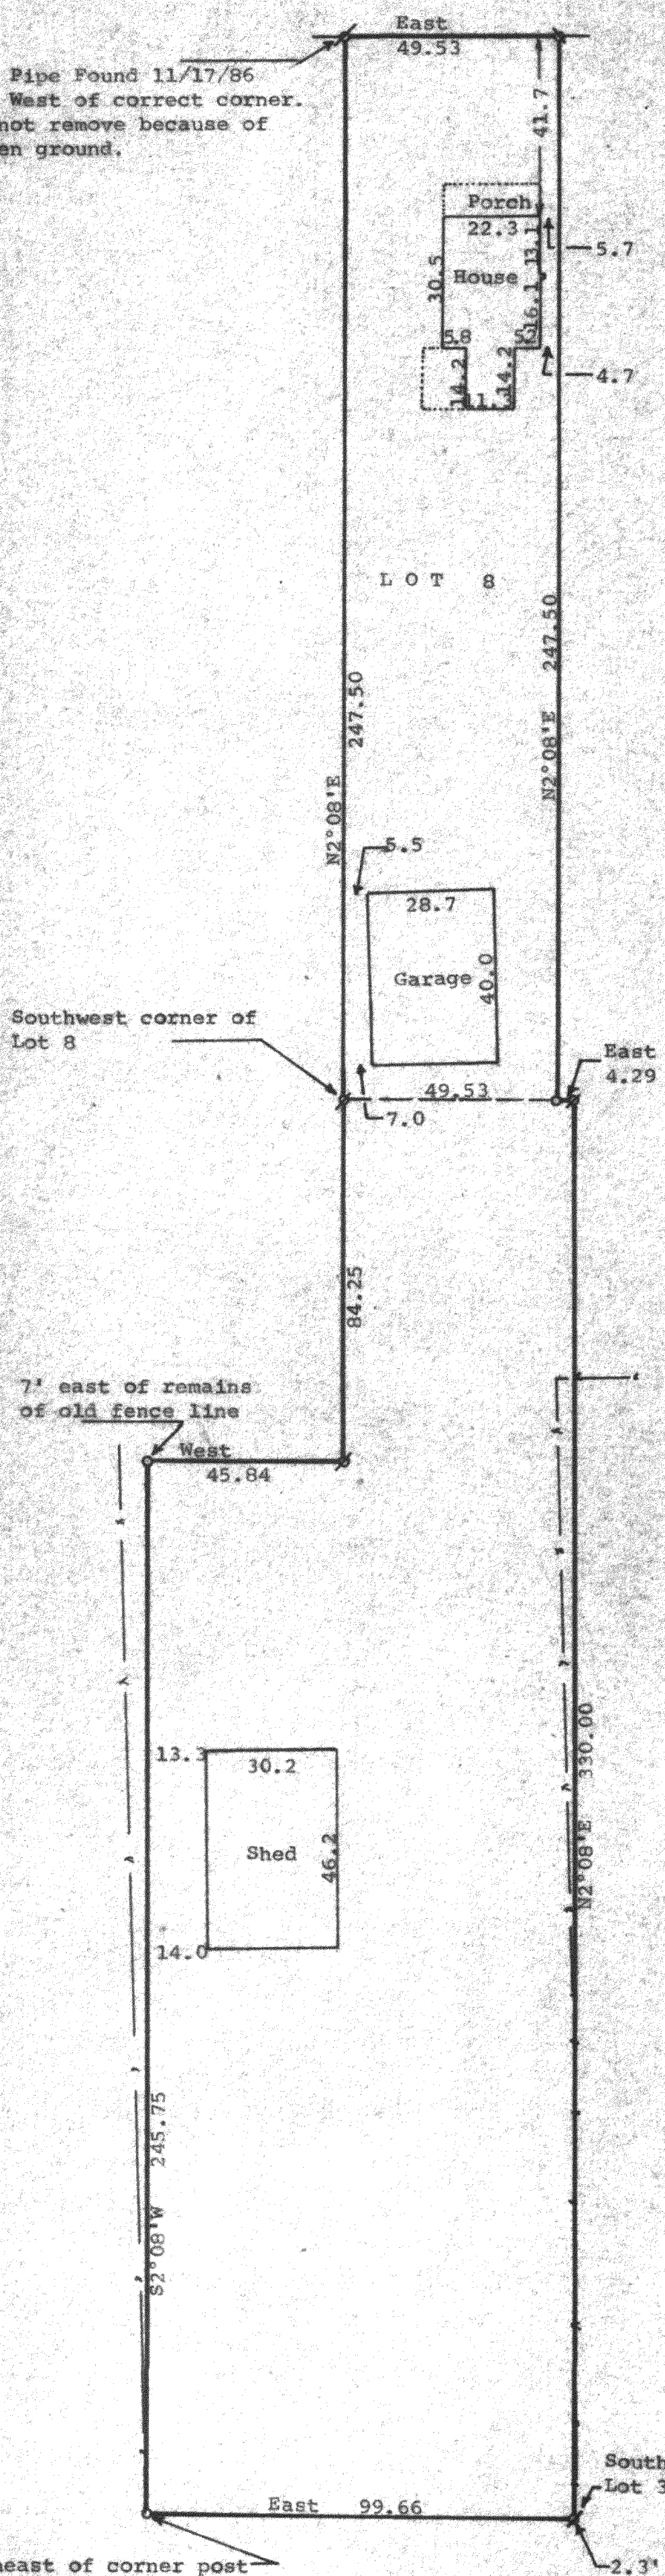

Scale - 1" = 30'
1" = 1" Iron Pipe Found
3/4" = 3/4" Iron Pipe Found
o = Iron Pipe Rust Mark Found in subsoil
1 1/2" X 24" Iron Pipe Set
--- Fence Line
Bearings referenced to assumed bearing of East along the south line of Pleasant Street
Owner: Carroll Gildemeister
Sharon, Wisconsin 53585

STATE OF WISCONSIN) SS
COUNTY OF WALWORTH)

I, George T. Dunham, Surveyor, certify that I have surveyed the property described as follows:

Lot 8 and a parcel of land located in the East 1/2 of Lot 38, all in Block 9 of Citizens Addition to the Village of Sharon, Walworth County, Wisconsin, described as follows: Beginning on the north line of said Lot 38 at the southwest corner of Lot 8 in said Block 9; thence South along the southerly extension of the west line of said Lot 8, 84.25 feet; thence West parallel with the north line of said Lot 38, 45.84 feet to the west line of said East 1/2 of Lot 38; thence South along the west line of said East 1/2 of Lot 38, 235.75 feet to the southwest corner of said East 1/2; thence East 99.66 feet to the southeast corner of said Lot 38; thence North 330.00 feet to the northeast corner of said Lot 38; thence West along the north line of said Lot 38, 51.85 feet to the place of beginning.

and that the map shown hereon is a correct representation thereof and shows the size and location of the property, its exterior boundaries, the location of all visible structures and dimensions of all principal buildings thereon, boundary fences, apparent easements, roadways and visible encroachments, if any, and that I have surveyed the property hereon described, according to the official records, to the best of my knowledge and belief.

George T. Dunham
George T. Dunham, Surveyor

