
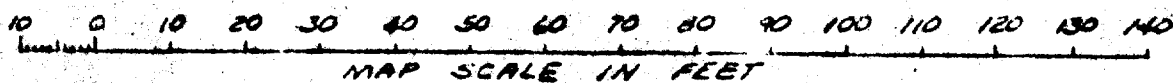


FARRIS, HANSEN & ASSOCIATES, INC.
7 RIDGEWAY COURT, ELKHORN, WI
414-723-2078

PLAT OF SURVEY OF

LOT 3 OF E.B.M. #1714 LOCATED IN THE SOUTHWEST 1/4 OF THE NORTHWEST 1/4
SECTION 33, TOWN 1 NORTH, RANGE 15 EAST, VILLAGE OF SHARON
WILMOTH COUNTY, WISCONSIN

WORK ORDERED BY: SOUTHEASTERN WISCONSIN HOUSING C/O BOB STEIN

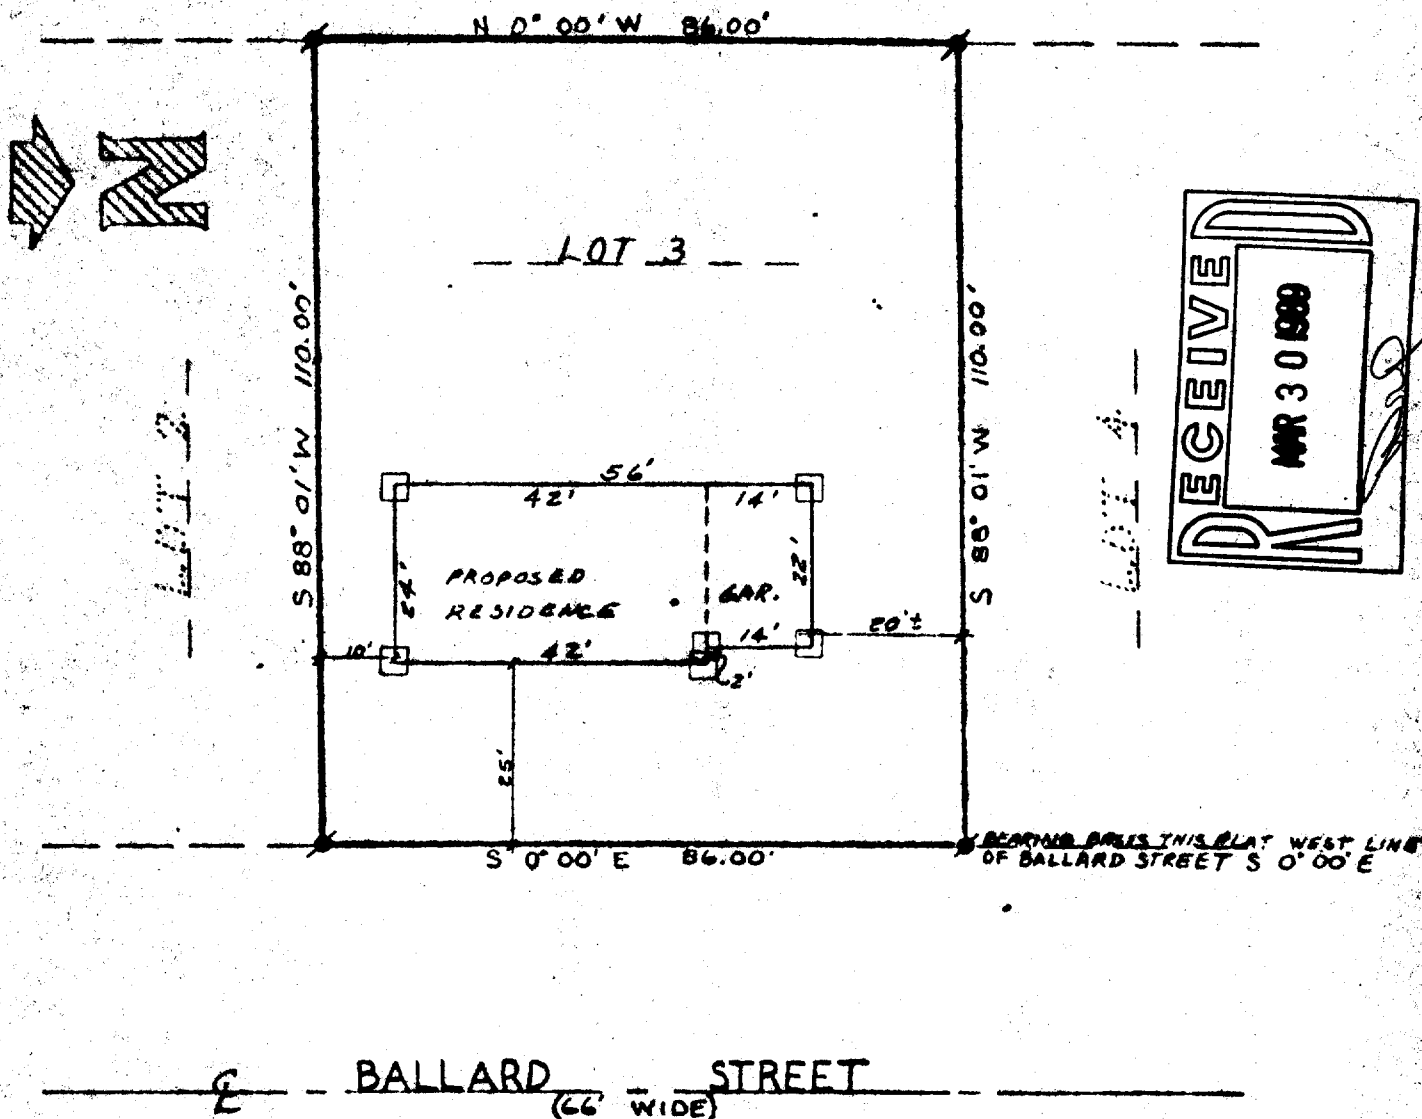


○ FOUND IRON PIPE STAKE ● SET RE-BAR STAKE ▲ FOUND RE-BAR
(x x) = ORIGINAL PLAT DIMENSION
□ = 1x2" WOOD STAKE SET

I hereby certify that this plat of survey is a true and accurate representation of the lot lines and proposed building location to the best of my knowledge and belief.

Robert A. Farris, H.L.S.

DATED: MARCH 22, 1989
REVISED: MARCH 29, 1989
AS STAKED

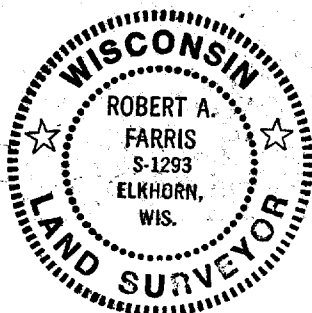

PROJECT # 1535, 1716, 3
8-148