



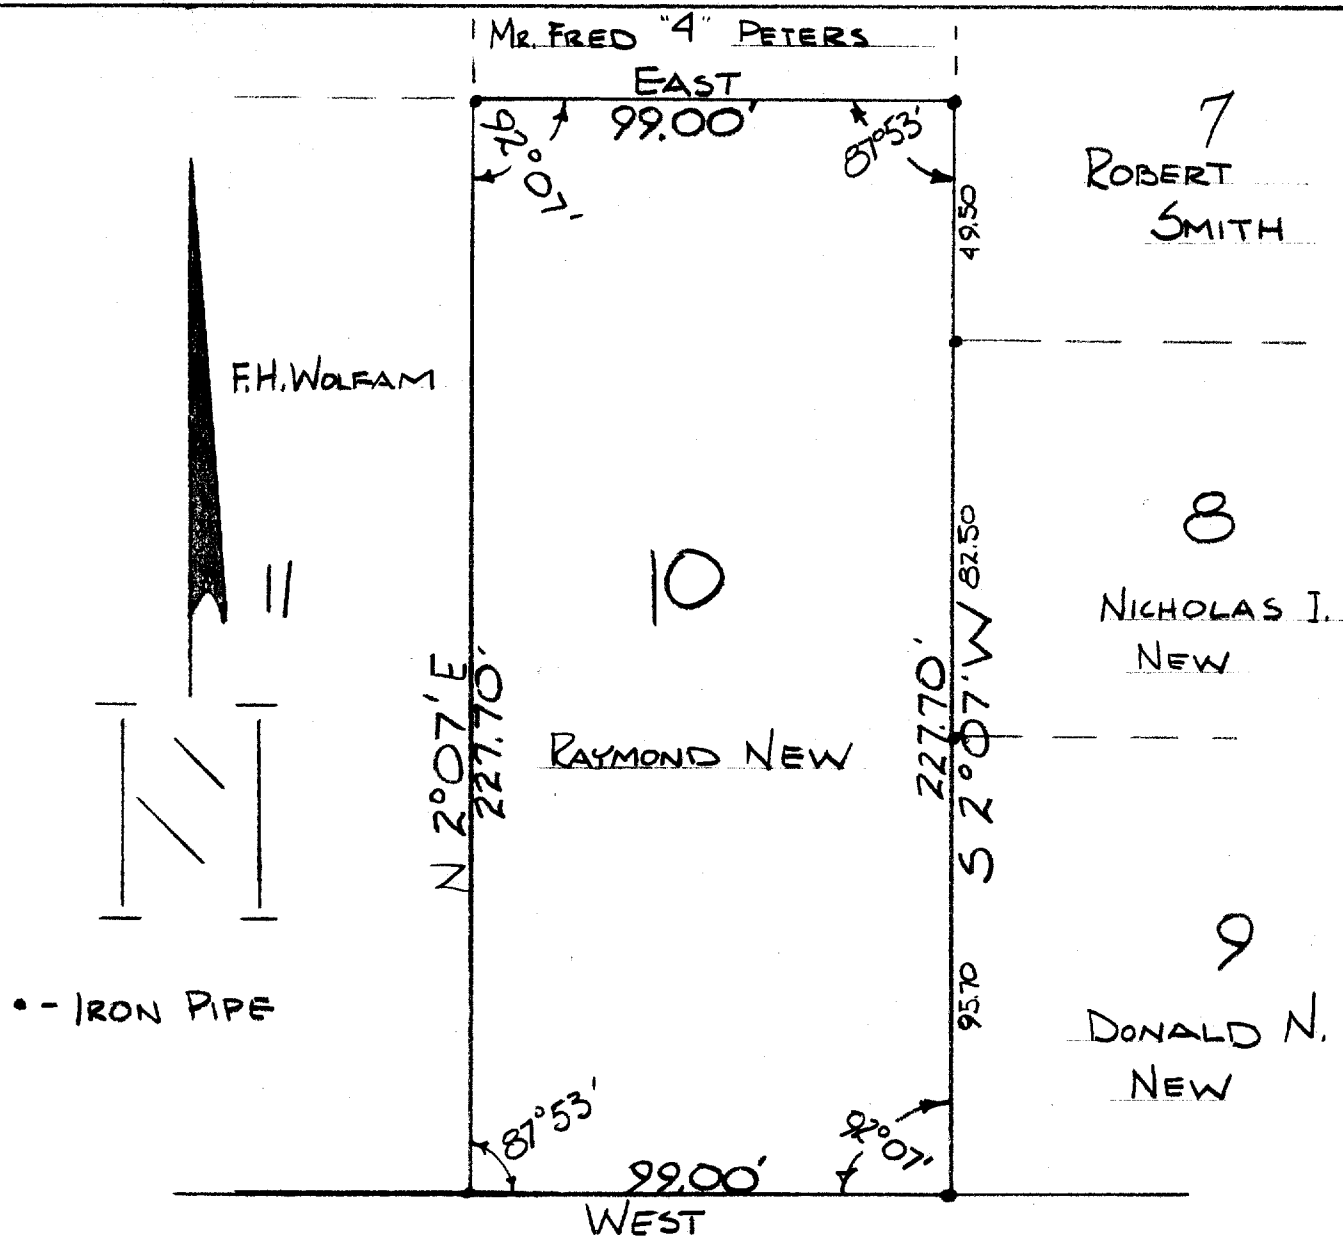

DOUGLASS STREET

DESCRIPTION: Lot 10 of Block 2 of Sharon Land Improvement Addition to the Village of Sharon, Walworth County, Wisconsin.

CERTIFICATE: I James F. Biagi, surveyor, do hereby certify that I have surveyed the property hereon described on this 24th day of April, 19

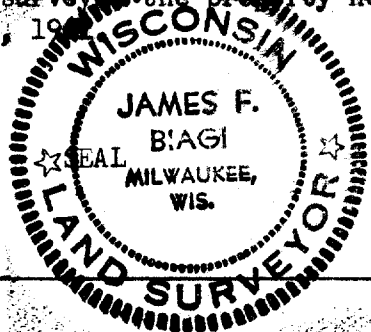

James F. Biagi
James F. Biagi RLS 272