


SCALE 1"=30'
O-IRON PIPE

BALLARD STREET

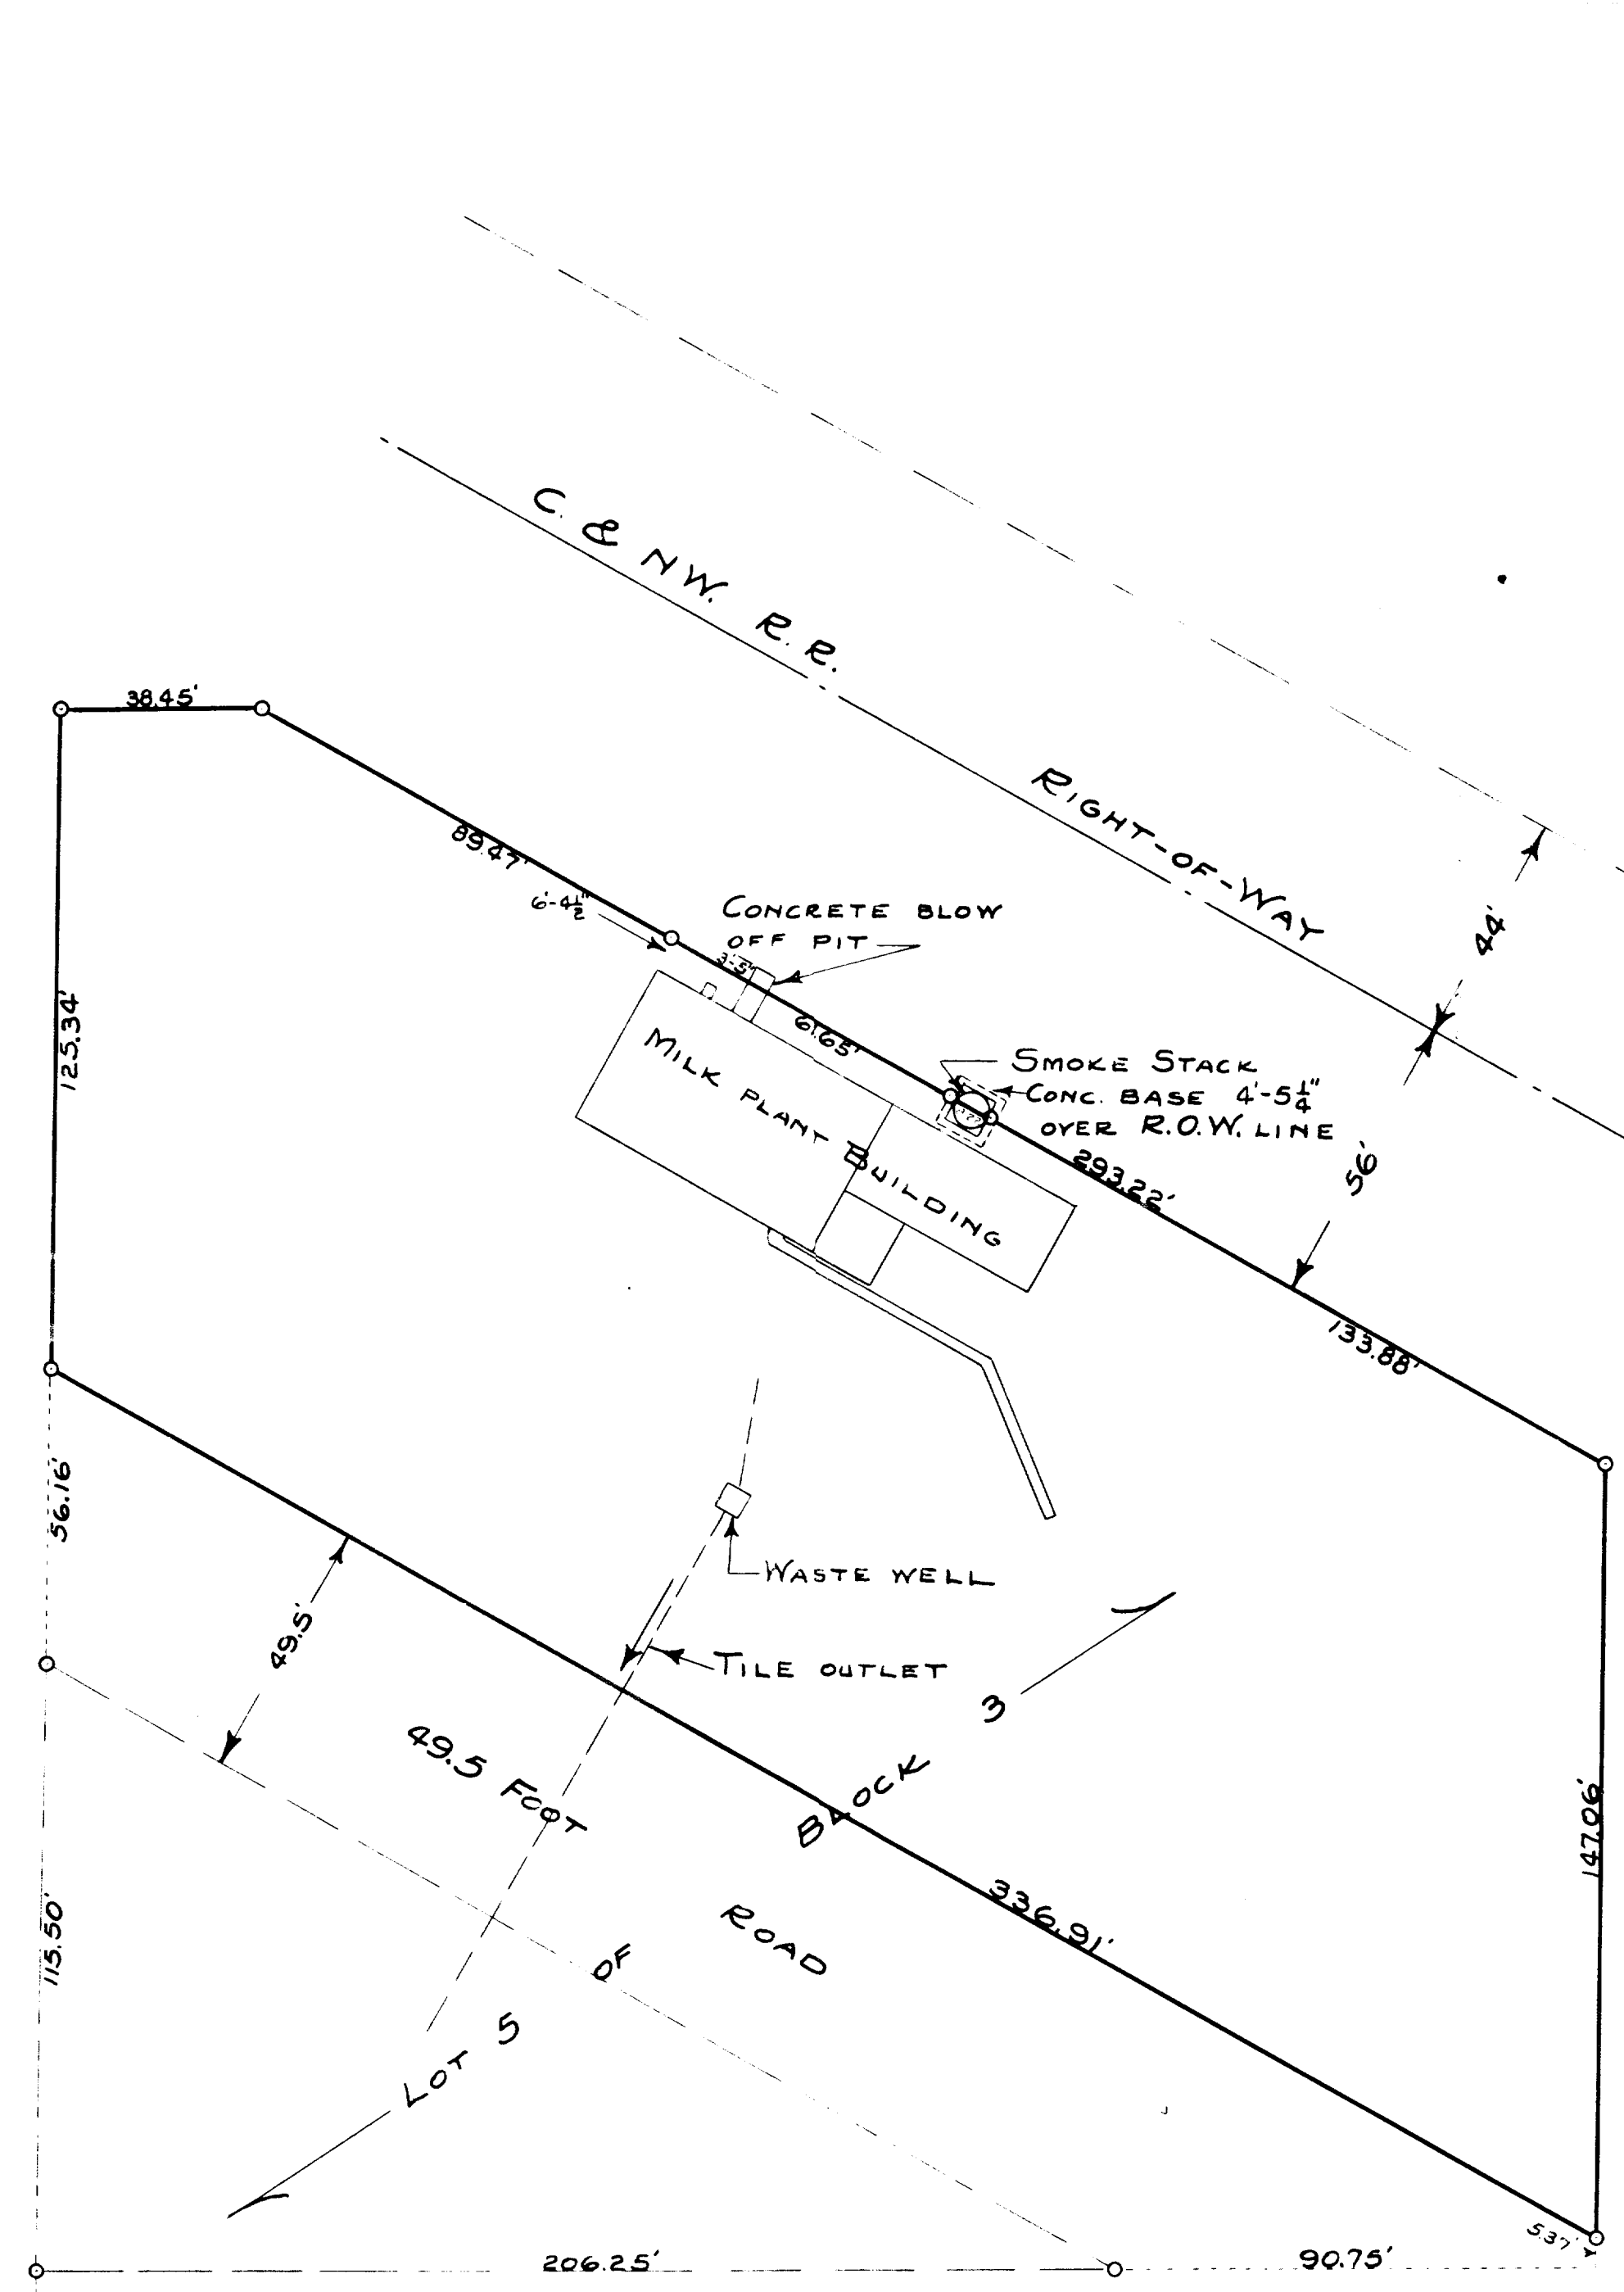

PLAT OF SURVEY OF ALL THAT PORTION OF LOT 5 OF
BLOCK 3 OF WISE AND NELSONS SOUTH SIDE ADDITION
TO THE VILLAGE OF SHARON WISCONSIN LYING NORTH OF
THE NORTH SIDE OF THE PUBLIC HIGHWAY RUNNING
ACROSS SAID LOT.

MAY 1944

Floyd T. Jensen
COUNTY SURVEYOR

U10135-22

8-1