


DUNHAM SURVEYING, S.C.
SURVEYING & SUBDIVIDING
DELAVER, WISCONSIN 53115

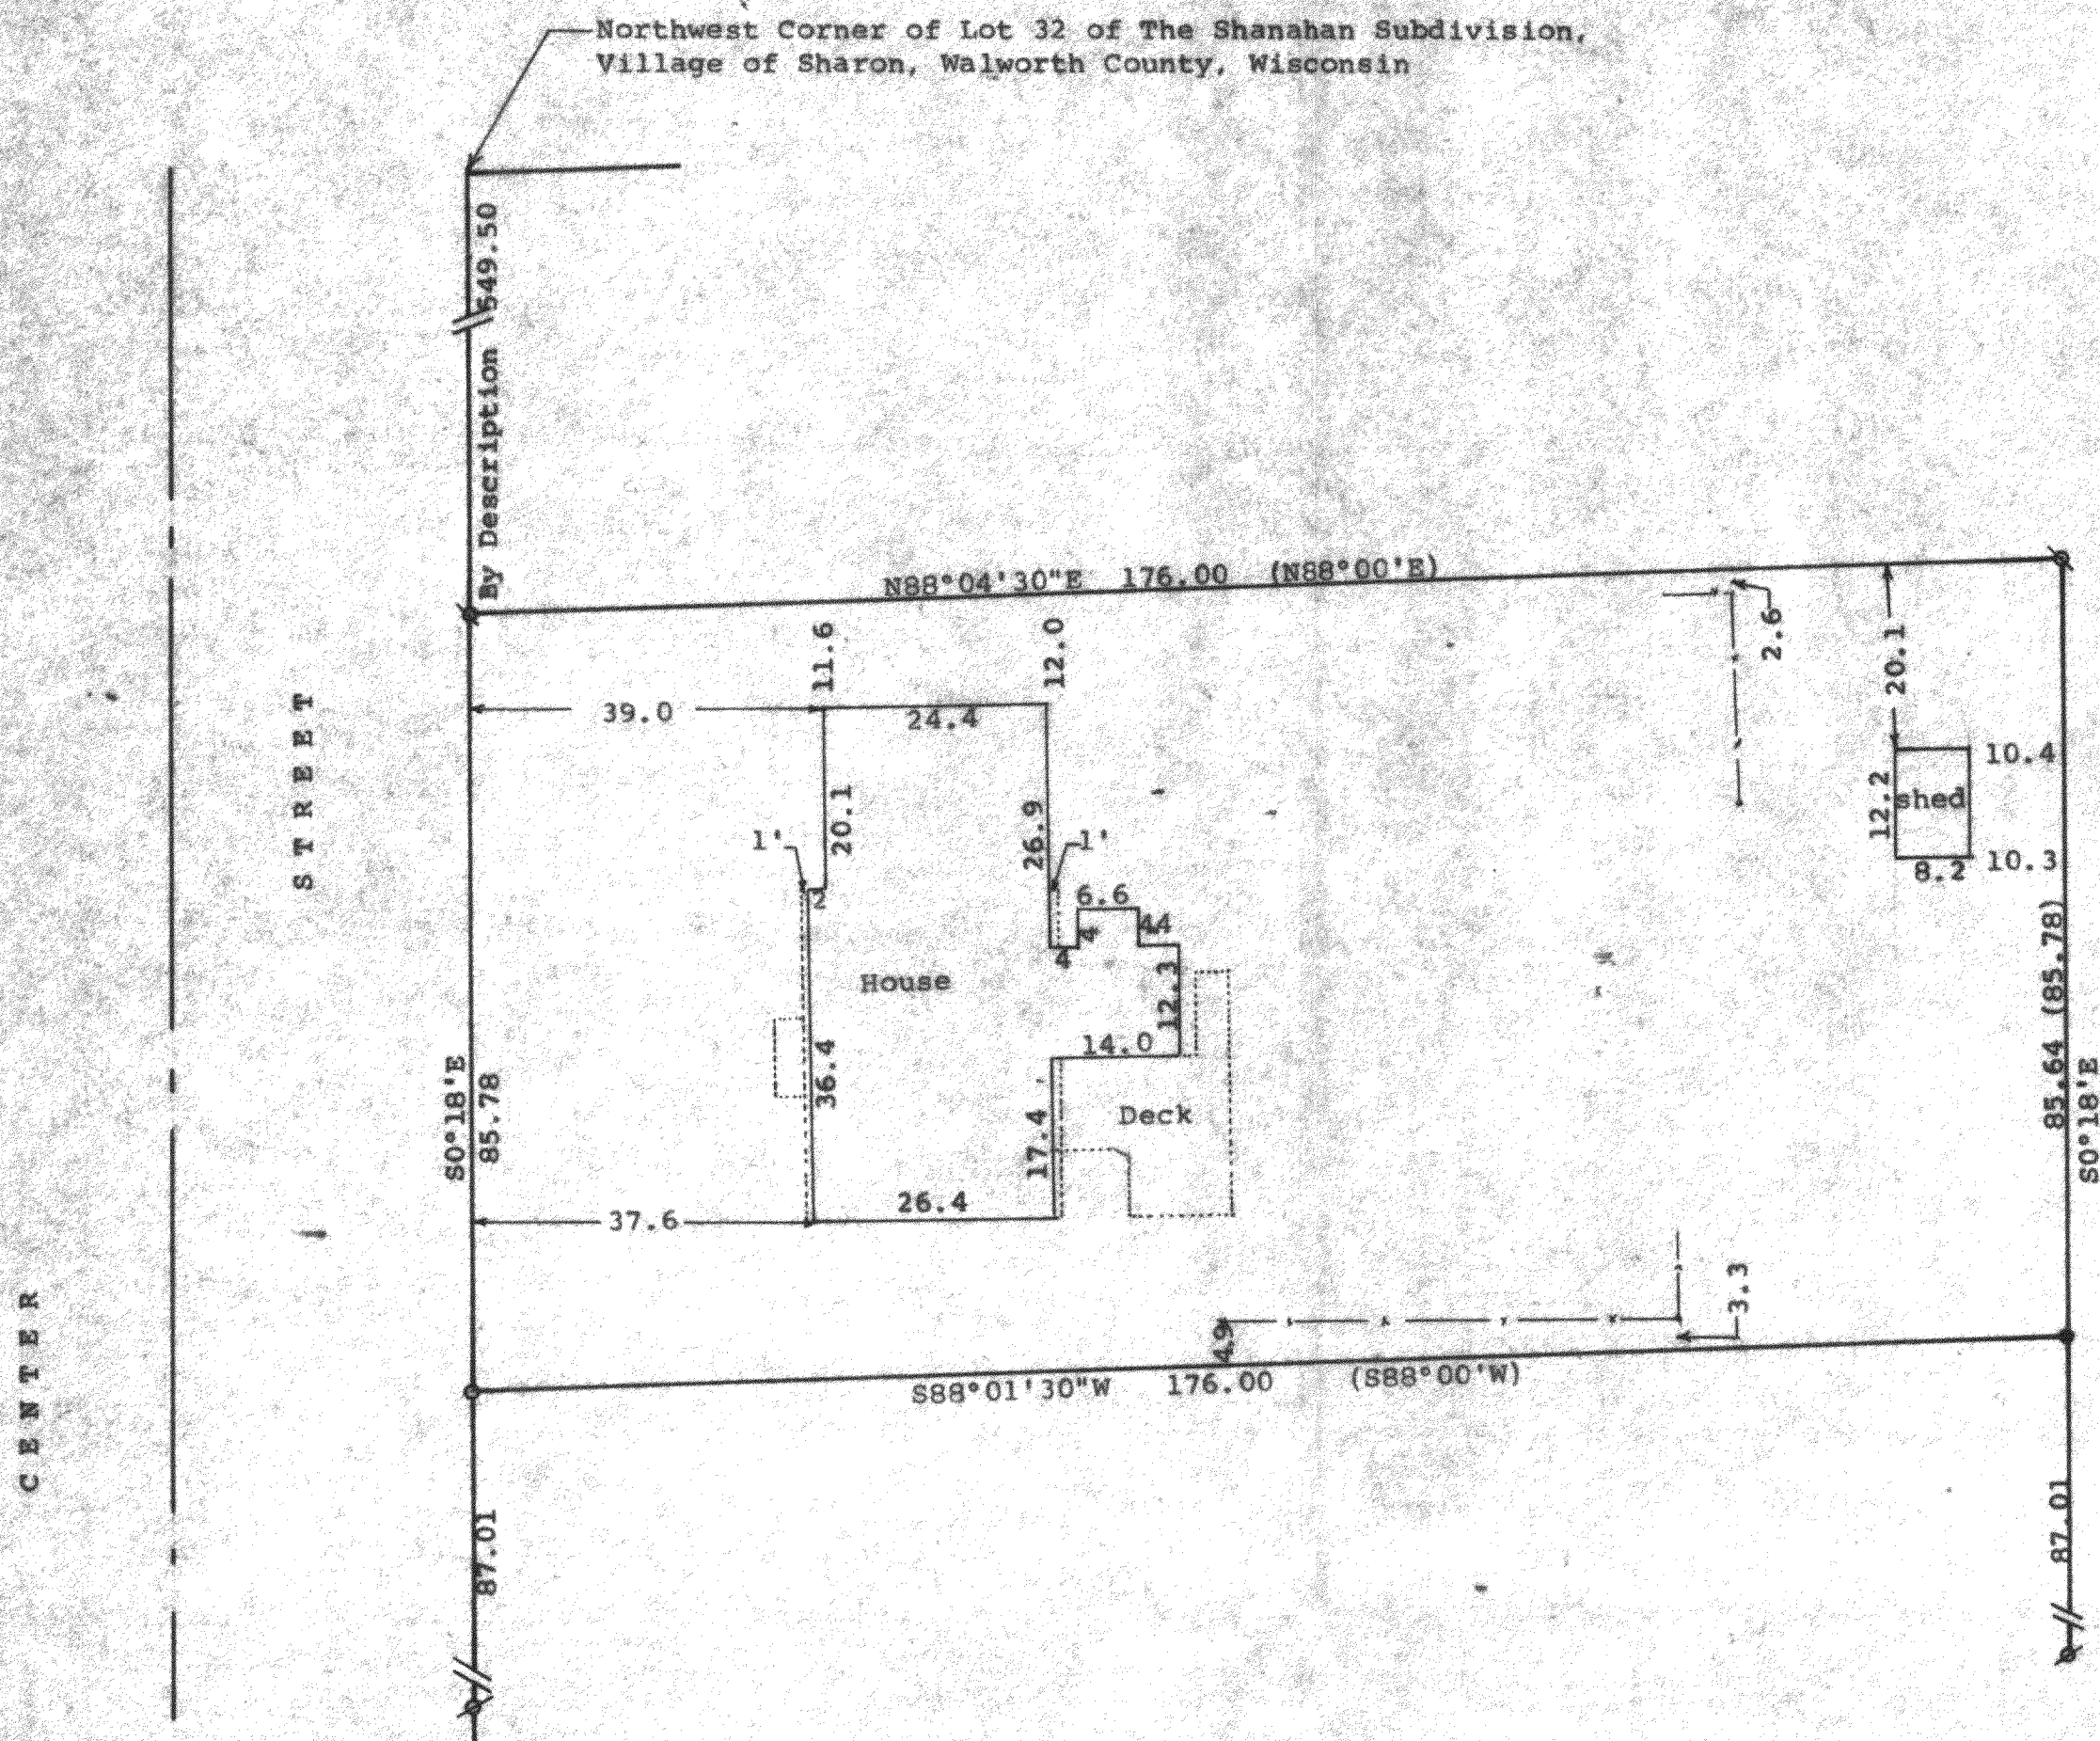

Scale - 1" = 20'

Ø = 1½" Iron Pipe Found

Q = 1½" Iron Pipe Found

o = 1" Iron Pipe Found

• = rust mark found in sub-soil. Set 1½" X 24" Iron Pipe

--- = Fence Line

(0°00') = recorded bearing or distance

Bearings referenced to the recorded bearing of S0°18'E along the east line of Center Street

Survey ordered by:
Action Realty
P. O. Box 324
Harvard, IL 60033

STATE OF WISCONSIN) SS
COUNTY OF WALWORTH)

I, George T. Dunham, Surveyor, certify that I have surveyed the property described as follows:

A part of Lot 20, Lot 21 and a part of Lot 22 of The Shanahan Subdivision located in the Village of Sharon, Walworth County, Wisconsin described as follows: Commencing at the northwest corner of Lot 32 of said The Shanahan Subdivision; thence S0°18'E along the east line of Center Street, 549.50 feet to the place of beginning; thence N88°00'E 176.00 feet; thence S0°18'E 85.78 feet; thence S88°00'W 176.00 feet; thence N0°18'W 85.78 feet to the place of beginning, subject to easements, of record

and that the plat shown hereon is a correct representation thereof and shows the size and location of the property, its exterior boundaries, the location of all visible structures and dimensions of all principal buildings thereon, boundary fences, apparent easements, roadways and visible encroachments, if any, and that I have surveyed the property hereon described, according to the official records, to the best of my knowledge and belief.

May 12, 1992

George T. Dunham
George T. Dunham, Surveyor

