


FARRIS, HANSEN & ASSOCIATES, INC.  
ENGINEERING, ARCHITECTURE, SURVEYING  
7 RIDGEWAY COURT - P.O. BOX 437, ELKHORN, WISCONSIN 53121  
PHONE: (414) 723-2098 FAX: (414) 723-5886

LOCATION: PART OF SHANAHAN  
SUBDIVISION LOCATED IN THE WEST 1/2  
OF THE NE 1/4 OF SEC. 33, T1N, R15E;  
VILLAGE OF SHARON, WALWORTH COUNTY,  
WISCONSIN

PLAT OF SURVEY  
PARCEL 9

WORK ORDERED BY: ED SLOPER LAND &  
REALTY CO.  
193 MICHAEL JOHN DR.  
PARK RIDGE, IL.

LEGEND  
● = SET IRON REBAR STAKE  
○ = FOUND IRON PIPE STAKE  
(XX) = RECORDED AS

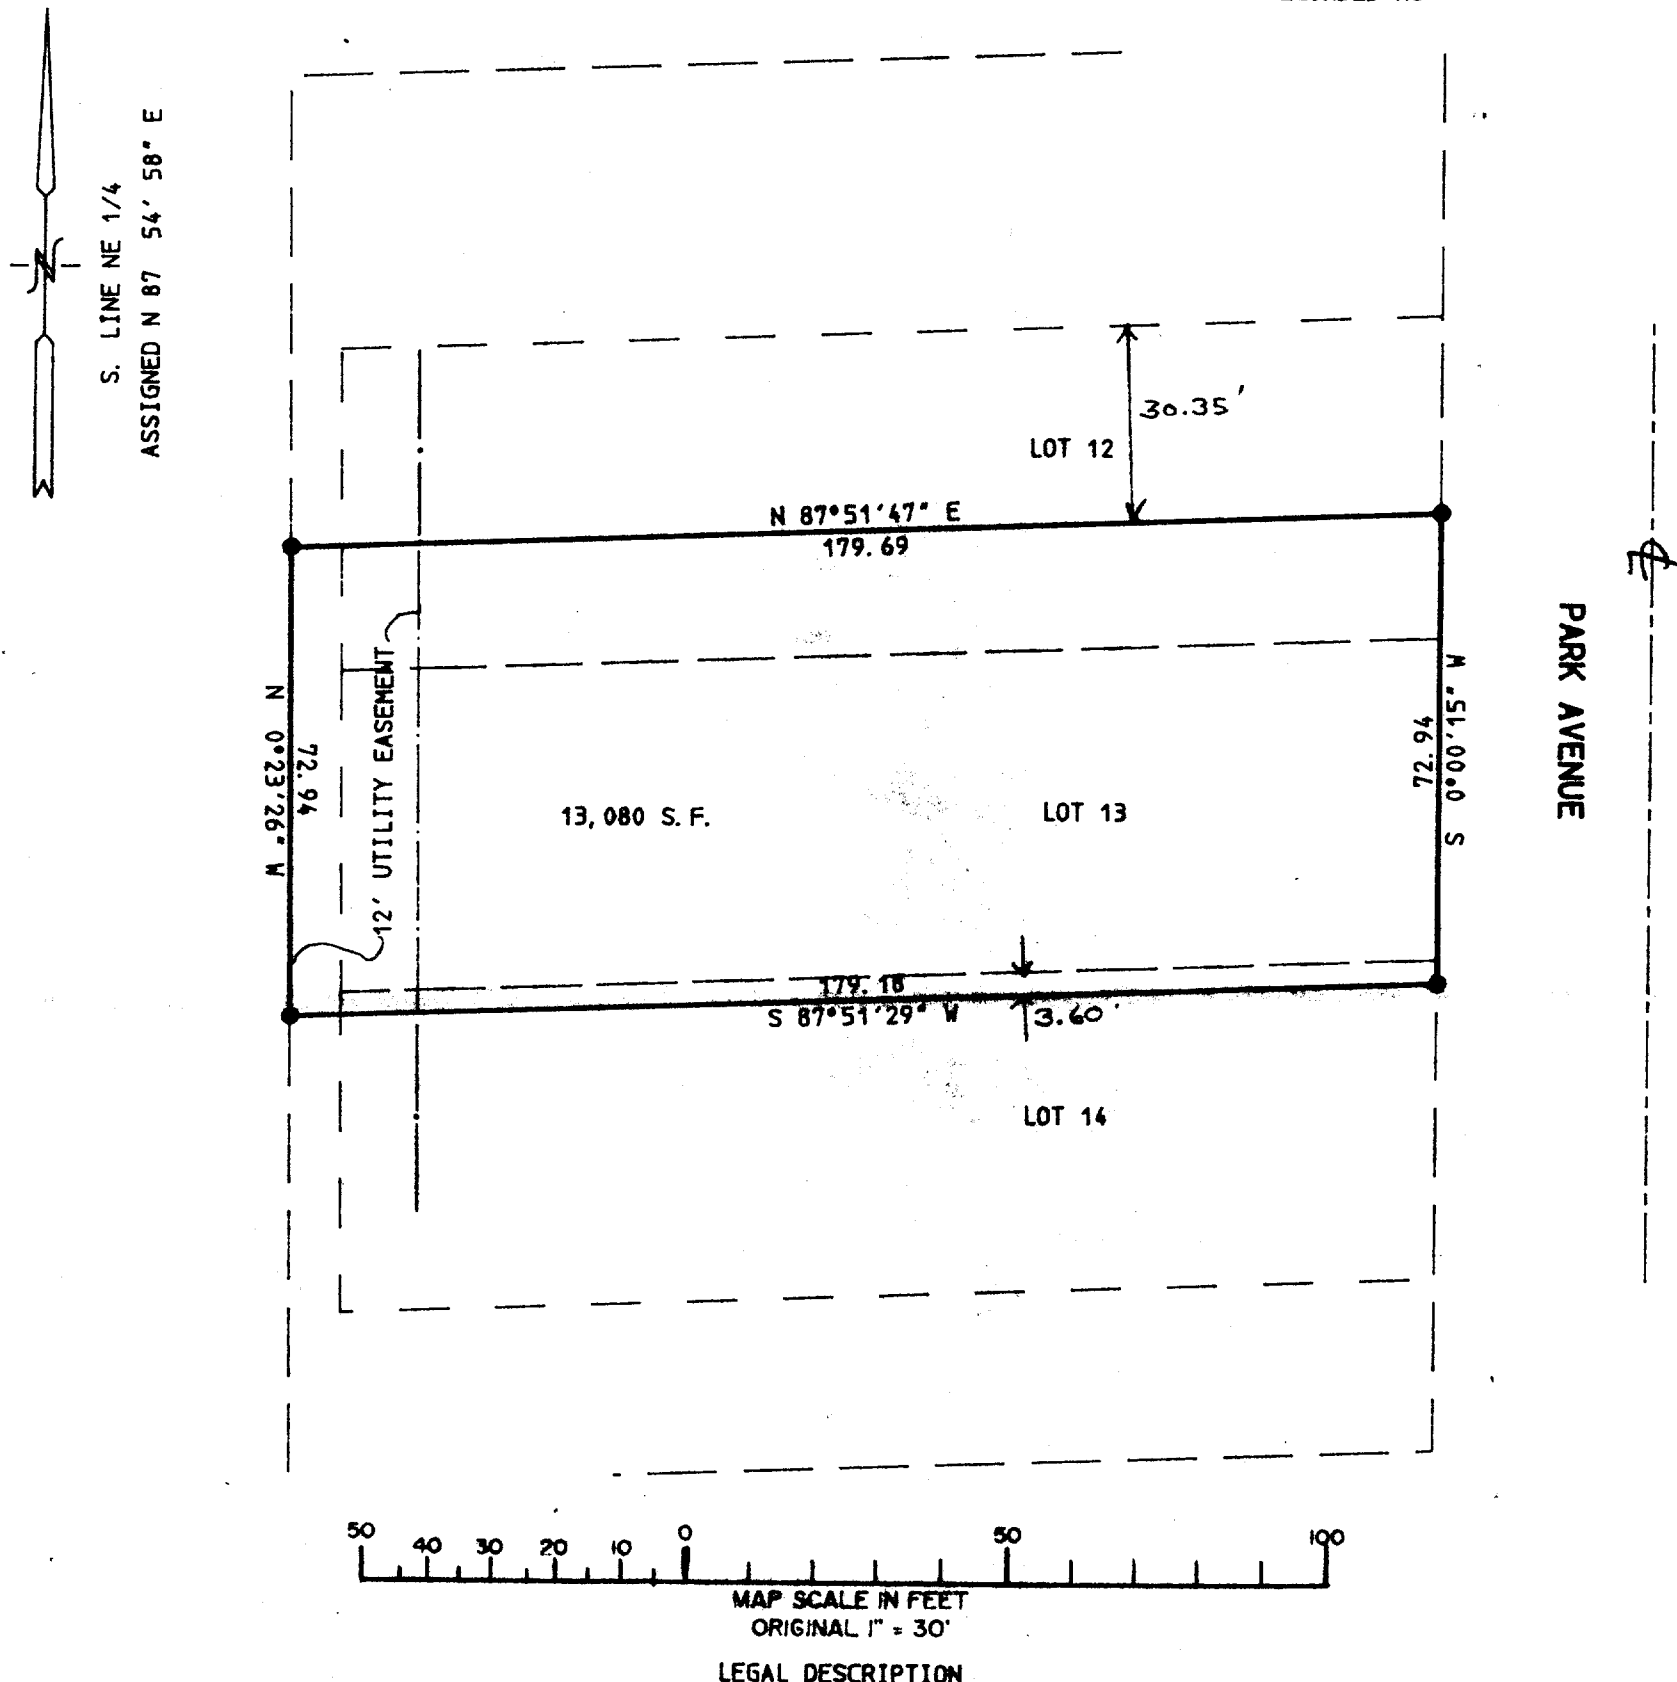


LEGAL DESCRIPTION  
A PARCEL OF LAND LOCATED IN THE WEST 1/2 OF THE NORTHEAST 1/4 OF SECTION 33, TOWN 1 NORTH, RANGE 15 EAST, VILLAGE OF SHARON, WALWORTH COUNTY, WISCONSIN; DESCRIBED AS:  
LOT 13 OF SHANAHAN SUBDIVISION; AND LOT 12 OF SAID SUBDIVISION EXCEPTING THE NORTH 30.35 FEET; AND THE NORTH 3.6 FEET OF LOT 14 OF SAID SUBDIVISION; AND A PARCEL DESCRIBED AS BEGINNING AT THE SOUTHWEST CORNER OF SAID LOT 13; THENCE S 00DEG 23MIN 26SEC E, 3.57 FEET; THENCE S 87DEG 51MIN 29SEC W, 8.00 FEET; THENCE N 00DEG 23MIN 26SEC W, 72.94 FEET; THENCE N 87DEG 51MIN 47SEC E, 8.00 FEET; THENCE S 00DEG 23MIN 26SEC E, 69.37 FEET TO THE POINT OF BEGINNING. SAID PARCEL CONTAINS 13,080 SQUARE FEET OF LAND MORE OR LESS.


NOTE: COPIES OF THIS MAP TO WHICH THE FOLLOWING CERTIFICATE WILL APPLY ARE BLUE LINE PRINTS SHOWING SURVEYOR'S ORIGINAL SEAL AND SIGNATURE IN BLACK INK. COPIES BY ANY OTHER MEANS MAY HAVE ALTERATIONS WHICH DO NOT REPRESENT THE SURVEYOR'S WORK PRODUCT.

I HEREBY CERTIFY THAT THE ABOVE DESCRIBED PROPERTY HAS BEEN SURVEYED UNDER MY DIRECTION AND THAT THE ABOVE MAP IS A TRUE REPRESENTATION THEREOF AND SHOWS THE SIZE AND LOCATION OF THE PROPERTY AND ITS EXTERIOR BOUNDARIES. THIS SURVEY IS MADE FOR THE USE OF THE PRESENT OWNERS OF THE PROPERTY, AND ALSO THOSE WHO PURCHASE, MORTGAGE, OR GUARANTEE THE TITLE THERETO WITHIN ONE YEAR FROM THE DATE HEREOF.

DATED: 5/11/94  
*Peter S. Gordon*

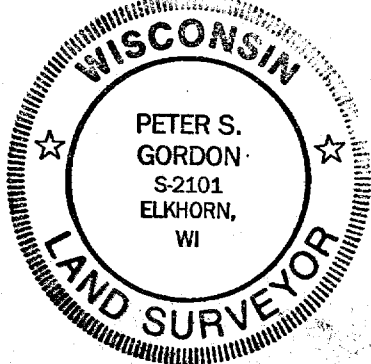

PROJ 3578  
DATED 05-08-1994

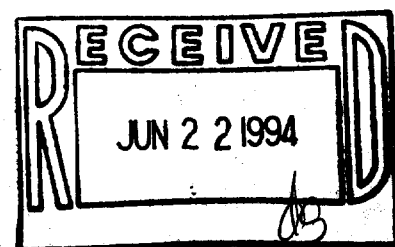

088-239